

Louises
H
2044

MISSISSIPPI DEPARTMENT OF NATURAL RESOURCES
 Bureau of Land and Water Resources
 Southport Mall
 P.O. Box 10631
 Jackson, Mississippi 39209
WATER WELL DRILLERS LOG

10-3 1983 Clardy Well Drilling Louises
 date well completed firm name county well located

LANDOWNER: Adam Whitfield
Rt 8 Box 14
Columbus, Miss.
 (mailing address)

WELL LOCATION:
 sec 22 T 18 N R 19 E
in city of Colo.
 (distance) miles (direction) of (nearest town)

WELL PURPOSE:
 (home, irrigation, municipal, industrial)

WELL COMPLETION DATA:

- (1) diameter (inches) 4"
- (2) total depth (feet) 140'
- (3) static water level (feet) 16' below ~~above~~ top of ground
- (4) casing PVC, 50'
 (material) (depth)
_____ if telescope see back.
 (size)
- (5) screen _____
 (length) (depth to top)
 (size) (material)
- (6) pump 1/2 850 gpm
 (HP) (yield gpm)
elec.
 (type power)
- (7) electric log no
 (yes or no)
 (organization running log)
- (8) how well bottom plugged _____

description of formations encountered	depth	
	from	to
<u>Gravel</u>	<u>0</u>	<u>32</u>
<u>Sandy blue. Clay</u>	<u>32</u>	<u>46</u>
<u>good blue. clay</u>	<u>46</u>	<u>52</u>
<u>Sandy Clay</u>	<u>52</u>	<u>72</u>
<u>heavy clay</u>	<u>72</u>	<u>82</u>
<u>RAE R1 2"</u>	<u>82</u>	
<u>blue. clay</u>	<u>82</u>	<u>94</u>
<u>sandy clay</u>	<u>94</u>	<u>104</u>
<u>sand</u>	<u>104</u>	<u>134</u>
<u>blue. clay</u>	<u>134</u>	<u>140</u>

DRILLERS REMARKS:


DEPT. OF NATURAL RESOURCES
 BUREAU OF LAND & WATER RESOURCES

DEC-7 1983

RECEIVED

If well telescopes please
sketch and show depths.

GROUND LEVEL

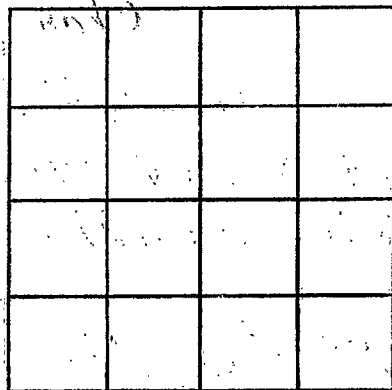

SECTION _____

Please indicate well location X.

ADDITIONAL INFORMATION

If more than one screen,
show locations of each on sketch.