

Lowndes
H 2045

MISSISSIPPI
 BOARD OF WATER COMMISSIONERS
 416 North State Street
 Jackson, Mississippi 39201

WATER WELL DRILLERS LOG

11-2 1983 North S. Kelly Lowndes
 date well completed firm name county well located

LANDOWNER: Dary Nickels

description of formations encountered	from	to
---------------------------------------	------	----

New Hope (Miss)
 (mailing address)

<u>Sandy clay</u>	<u>0</u>	<u>18</u>
-------------------	----------	-----------

WELL LOCATION:
 sec. 2 T 18 N R 17 E
1/2 mi. East of Lowndes of Racetrack
 (distance) (direction) (nearest town)

<u>Sand + gravel</u>	<u>18</u>	<u>68</u>
----------------------	-----------	-----------

<u>Blue shale</u>	<u>68</u>	<u>210</u>
-------------------	-----------	------------

<u>Blue clay + sand</u>	<u>210</u>	<u>240</u>
-------------------------	------------	------------

WELL PURPOSE: Home
 (home, irrigation, municipal, industrial)

WELL COMPLETION DATA:

- (1) diameter (inches) 8"
- (2) total depth (feet) 240
- (3) static water level (feet) 102 below above top of ground.
- (4) casing P.V.C. 145'
 (material) (depth)
 (size) if telescope see back.
- (5) screen 145' 102'
 (length) (depth to top)
 (size) (material)
- (6) pump 3/4" 10
 (HP) (yield gpm)
E
 (type power)
- (7) electric log no
 (yes or no)
 (organization running log)

(8) how well bottom plugged: open

DRILLERS REMARKS:


DEPT. OF NATURAL RESOURCES
 BUREAU OF LAND & WATER RESOURCES

NOV 16 1983

RECEIVED

If well telescopes please sketch and show depths.

GROUND LEVEL

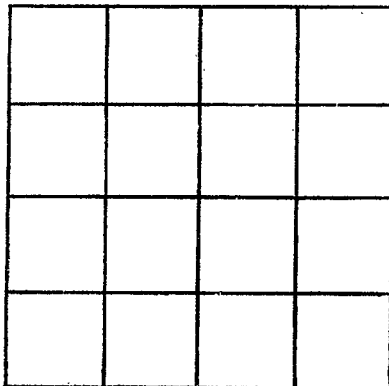

SECTION _____

Please indicate well location X.

ADDITIONAL INFORMATION

If more than one screen,
show locations of each on sketch.