

MISSISSIPPI DEPARTMENT OF NATURAL RESOURCES

Bureau of Land and Water Resources

Southport Mall

P.O. Box 10631

Jackson, Mississippi 39209

WATER WELL DRILLERS LOG

Lowder  
H  
2047

3-22

Clardy Well Drilling Lowder

date well completed

firm name

county well located

LANDOWNER: Senis, Boston  
 Hwy 82 W.  
 Columbus, MS  
 (mailing address)

WELL LOCATION:  
 sec. 36 T. 18 N R. 13 E  
2 1/2 miles SW of Calo  
 (distance) (direction) (nearest town)

WELL PURPOSE: home  
 (home, irrigation, municipal, industrial)

WELL COMPLETION DATA:

- (1) diameter (inches) 4"
- (2) total depth (feet) 282'
- (3) static water level (feet) 18' below top of ground.
- (4) casing PVC 91'  
 (material) (depth)  
 (size) if telescope see back.
- (5) screen \_\_\_\_\_  
 (length) (depth to top)  
 (size) (material)
- (6) pump 1/2 900'  
 (HP) (yield gpm) gph  
elec.  
 (type power)
- (7) electric log no  
 (yes or no)  
 (organization running log)
- (8) how well bottom plugged \_\_\_\_\_

description of formations encountered	from	to
Clay	0	7
sand & gravel	7	38
rock	38	
sandy clay	38	57
rock 6"	57	
sandy clay	57 1/2	88
fair clay	88	91
D good cldy	91	93
sandy clay	93	168
sand	168	170
sandy clay	170	175
sand	175	183
hard clay	183	211
rock	211	212
sand	212	216
hard cl.	216	228
gummy clay	228	236
hard clay	236	249
sand	249	269
rock 6"	269	
sand	269 1/2	282

DEPT. OF NATURAL RESOURCES  
 BUREAU OF LAND & WATER RESOURCES


APR 30 1984

RECEIVED

DRILLERS REMARKS:

If well telescopes please sketch and show depths.

GROUND LEVEL

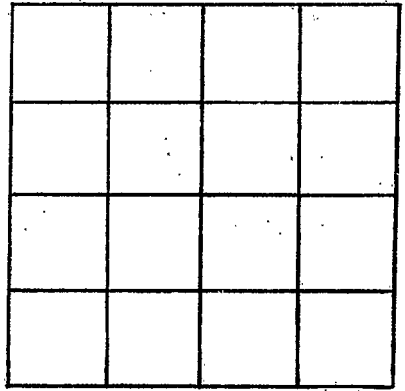

SECTION \_\_\_\_\_

Please indicate well location X.

ADDITIONAL INFORMATION

If more than one screen,  
show locations of each on sketch.