

MISSISSIPPI DEPARTMENT OF NATURAL RESOURCES

Bureau of Land and Water Resources

Southport Mall

P.O. Box 10631

Jackson, Mississippi 39209

WATER WELL DRILLERS LOG

Lowndes
H 2048

5-29-84 19 Lowndes Clardy Well Drilling Lowndes
date well completed firm name county well located

LANDOWNER: Reuben Kendrick
 Hwy 50
 Columbus, Miss
(mailing address)

WELL LOCATION:
sec. 6 T. 18 N. R. 17 E.
1/2 miles NE of Colum
(distance) (direction) (nearest town)

WELL PURPOSE: home
(home, irrigation, municipal, industrial)

WELL COMPLETION DATA:

- (1) diameter (inches) 4"
- (2) total depth (feet) 190'
- (3) static water level (feet) 16 below above top of ground.
- (4) casing PVC, 80',
(material) (depth)
If telescope see back.
(size)
- (5) screen _____
(length) (depth to top)
(size) (material)
- (6) pump 1/2 850 gph
(HP) (yield gpm)
elec
(type power)
- (7) electric log no
(yes or no)
(organization running log)
- (8) how well bottom plugged _____

description of formations encountered	from	to
gravel	6	19
rock	19	19 1/2
sand & gravel	19 1/2	25
sandy blue clay	25	45
good clay	45	51 1/2
rock	51 1/2	52
good clay	52	85
rock 16"	85	85 1/2
sandy clay	85 1/2	100
brown clay	100	106
blue clay	106	112
sandy clay	112	115
blue clay	115	122
rock	122	122 1/2
hard blue clay	122 1/2	135
sand	135	145
hard clay	145	147
brown clay	147	153
rock	153	156
brown clay	156	160
sand	160	190


DEPT. OF NATURAL RESOURCES
BUREAU OF LAND & WATER RESOURCES

JUL - 2 1984
RECEIVED

DRILLERS REMARKS: _____

If well telescopes please sketch and show depths.

GROUND LEVEL

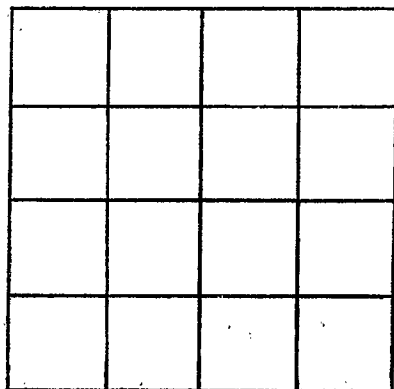

SECTION _____

Please indicate well location X.

ADDITIONAL INFORMATION

If more than one screen,
show locations of each on sketch.