

MISSISSIPPI DEPARTMENT OF NATURAL RESOURCES

Bureau of Land and Water Resources

Southport Mall

P.O. Box 10631

Jackson, Mississippi 39209

WATER WELL DRILLERS LOG

Counties
H
2049

9-11-84

date well completed

Clardy Well Drilling Lowndes

firm name

county well located

LANDOWNER: Carl Sexty

Highway 50

Columbus, Ms.

(mailing address)

WELL LOCATION:

sec. 4 T. 18 N. R. 19 E
 (S) (W)
2 1/2 miles NE of Cobscook
 (distance) (direction) (nearest town)

WELL PURPOSE: Home
 (home, irrigation, municipal, industrial)

WELL COMPLETION DATA:

- (1) diameter (inches) 4"
- (2) total depth (feet) 126'
- (3) static water level (feet) 28' below above top of ground.
- (4) casing PVC 90'
(material) (depth)
 if telescope see back.
(size)
- (5) screen
(length) (depth to top)
 (size) (material)
- (6) pump 1/2 900gph
(HP) (yield gph)
elec.
(type power)
- (7) electric log no
(yes or no)

(organization running log)
- (8) how well bottom plugged

description of formations encountered	from	to
<u>red clay</u>	<u>0</u>	<u>18</u>
<u>sand & gravel</u>	<u>18</u>	<u>58</u>
<u>blue clay</u>	<u>58</u>	<u>70</u>
<u>rocks</u>	<u>70</u>	<u>70 1/2</u>
<u>blue clay</u>	<u>70 1/2</u>	<u>84</u>
<u>good blue clay</u>	<u>84</u>	<u>105</u>
<u>David</u>	<u>105</u>	<u>126</u>

DRILLERS REMARKS:


DEPT. OF NATURAL RESOURCES
BUREAU OF LAND & WATER RESOURCES

OCT 22 1984

RECEIVED

If well telescopes please sketch and show depths.

GROUND LEVEL

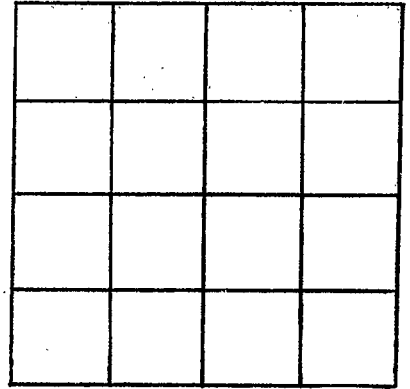

SECTION _____

Please indicate well location X.

ADDITIONAL INFORMATION

If more than one screen,
show locations of each on sketch.