

MISSISSIPPI DEPARTMENT OF NATURAL RESOURCES

Bureau of Land and Water Resources

Southport Mall

P.O. Box 10631

Jackson, Mississippi 39209

WATER WELL DRILLERS LOG

Lowndes
H
2052

11-15 19
 date well completed

Clardy well Drilling Lowndes
 firm name county well located

LANDOWNER: Robert Chism

description of formations encountered

from to

Tracy So
Cals. m.s.
 (mailing address)

<u>Brown clay</u>	<u>0</u>	<u>15</u>
<u>Sand & gravel</u>	<u>15</u>	<u>38</u>
<u>blue clay</u>	<u>38</u>	<u>64</u>
<u>good blue clay</u>	<u>64</u>	<u>78</u>
<u>Sand & rock</u>	<u>78</u>	<u>80</u>
<u>good clay</u>	<u>80</u>	<u>100</u>
<u>bandy clay</u>	<u>100</u>	<u>119</u>
<u>hard clay</u>	<u>119</u>	<u>127</u>
<u>rock</u>	<u>127</u>	<u>127.5</u>
<u>hard clay</u>	<u>127.5</u>	<u>160</u>
<u>good rock</u>	<u>160</u>	<u>210</u>

WELL LOCATION:

sec. 4 T. 18 N. R. 17 E
2 1/4 miles E of Cals.
 (distance) (direction) (nearest town)

WELL PURPOSE: home
 (home, irrigation, municipal, industrial)

WELL COMPLETION DATA:

- (1) diameter (inches) 4"
- (2) total depth (feet) 210'
- (3) static water level (feet) 28' below top of ground.
- (4) casing PVC, 96' (material) (depth)
4" if telescope see back. (size)
- (5) screen _____ (length) (depth to top)
 (size) (material)
- (6) pump 1/2 850 gph. (HP) (yield gpm)
elec (type power)
- (7) electric log no (yes or no)
 (organization running log)
- (8) how well bottom plugged _____

MISSISSIPPI DEPARTMENT OF NATURAL RESOURCES
 BUREAU OF LAND & WATER RESOURCES

DEC 27 1984


RECEIVED

DRILLERS REMARKS:

near Carl Sewastoy

If well telescopes please sketch and show depths.

GROUND LEVEL

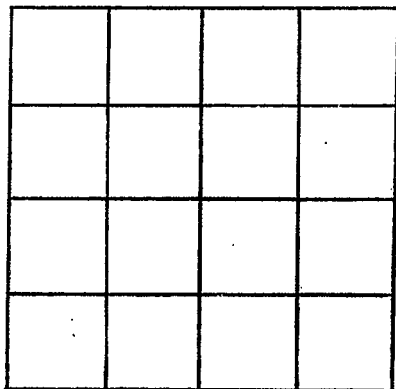

SECTION _____

Please indicate well location X.

ADDITIONAL INFORMATION

If more than one screen,
show locations of each on sketch.