

MISSISSIPPI DEPARTMENT OF NATURAL RESOURCES

Bureau of Land and Water Resources

Southport Mall

P.O. Box 10631

Jackson, Mississippi 39209

WATER WELL DRILLERS LOG

LOWNDES
H 2053

3-15-85
date well completed

Clardy Well Drilling Lowndes
firm name

county well located

LANDOWNER: Rusty House

Price Rd.

Columbus, MS
(mailing address)

WELL LOCATION:

sec 30 T 18 N R 14 ^{7W}

2 miles E. of Colo.
(distance) (direction) (nearest town)

WELL PURPOSE: Home
(home, irrigation, municipal, industrial)

WELL COMPLETION DATA:

(1) diameter (inches) 4"

(2) total depth (feet) 231

(3) static water level (feet) 30' below top of ground

(4) casing PVC, 117'
(material) (depth)

(size) If telescope see back.

(5) screen (length) (depth to top)

(size) (material)

(6) pump (HP) (yield gpm)

(type power)

(7) electric log (yes or no)

(organization running log)

(8) how well bottom plugged

DRILLERS REMARKS:


description of formations encountered	from	to
Red Clay	0	17
sand	17	23
sand & gravel	23	38
hard blk. clay	38	59
sandy clay	59	71
good clay	71	119
rock 6"Ø		
hard clay	119 1/2	137
sandy clay	137	148
hard clay	148	167
sandy clay	167	183
sand	183	204
good sand	204	231

RECEIVED
APR 27 1985

Mississippi Department of Natural Resources
Bureau of Land & Water Resources

If well telescopes please sketch and show depths.

GROUND LEVEL

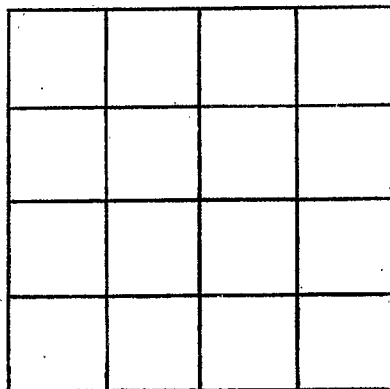

SECTION _____

Please indicate well location X.

ADDITIONAL INFORMATION

If more than one screen,
show locations of each on sketch.