

MISSISSIPPI DEPARTMENT OF NATURAL RESOURCES

Bureau of Land and Water Resources

Southport Mall

P.O. Box 10631

Jackson, Mississippi 39209

WATER WELL DRILLERS LOG

LOWNDES

H

2054

5-30-85
date well completed

Clardy Well Drilling Lowndes
firm name county well located

LANDOWNER: Russell Flood

220 Hartley Dr.

Cole, MS.

(mailing address)

WELL LOCATION:

sec. 7 T. 18 N. R. 17 W. E 1/4

1/4 miles E of Cole (distance) (direction) (nearest town)

WELL PURPOSE: home (home, irrigation, municipal, industrial)

WELL COMPLETION DATA:

(1) diameter (inches) 4"

(2) total depth (feet) 188'

(3) static water level (feet) 20' below top of ground.

(4) casing PVC 74' (material) (depth)

4" (size) if telescope see back.

(5) screen (length) (depth to top)

(size) (material)

(6) pump 1/2 HP 900 gpb (HP) (yield gpm)

elec. (type power)

(7) electric log no. (yes or no)

(organization running log)

(8) how well bottom plugged

description of formations encountered

from to

brown clay	0	10
sand & gravel	10	25 1/2
reddish clay	25 1/2	61 1/2
good blue clay	61 1/2	66
soft blue clay	66	69
blue clay	69	92 1/2
rock	92 1/2	93 1/2
clay	93 1/2	94 1/2
rock	94 1/2	95
clay	95	97
rock	97	97 1/2
clay	97 1/2	99
rock		
sandy	99	109
clay	109	150
sand	150	151
brown clay	151	175
good sand	175	188

DRILLERS REMARKS:


RECEIVED

JUN 21 1985

Department of Natural Resources
Bureau of Land & Water Resources

If well telescopes please sketch and show depths.

GROUND LEVEL

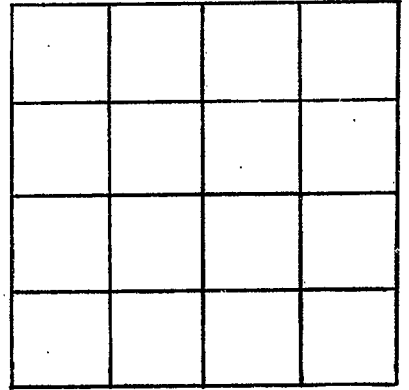

SECTION _____

Please indicate well location X.

ADDITIONAL INFORMATION

If more than one screen,
show locations of each on sketch.