


MISSISSIPPI DEPARTMENT OF NATURAL RESOURCES
Bureau of Land and Water Resources
 Southport Mall
 P.O. Box 10631
 Jackson, Mississippi 39209
WATER WELL DRILLERS LOG

LOWNDES

H 2056

10-23-85 19 Clardy Well Drilling Lowndes
 date well completed firm name county well located

LANDOWNER: John Chain
Schenberg Rd.
Columbus, Ms.
 (mailing address)

WELL LOCATION:
 sec. 7 T. 18 N. R. 19 E
at City Limits
 miles of (distance) (direction) (nearest town)

WELL PURPOSE: home
 (home, irrigation, municipal, industrial)

- WELL COMPLETION DATA:
- (1) diameter (inches) 4"
 - (2) total depth (feet) 161'
 - (3) static water level (feet) 18' below above top of ground.
 - (4) casing PVC, 72 1/2'
 (material) (depth)
4"
 (size) if telescope see back.
 - (5) screen _____
 (length) (depth to top)
 (size) (material)
 - (6) pump 1/2 900 gph.
 (HP) (yield gpm)
 - elec.
 (type power)
 - (7) electric log no
 (yes or no)
 (organization running log)
 - (8) how well bottom plugged _____

description of formations encountered	from	to
brown clay	0	13
sand & gravel	13	26
sandy blue clay	26	72
blue clay	72	75
rock	75	76 1/2
blue clay	76 1/2	79
rock	79	79
clay	79	85
rock	85	85
clay	85	87
rock	87	87
blue clay	87	128
rock	128	
sand	130	131
clay	131	136
streaks of sand	136	146
good sand	146	161


RECEIVED
 NOV 27 1985

Department of Natural Resources
 Bureau of Land & Water Resources

DRILLERS REMARKS:

If well telescopes please sketch and show depths.

GROUND LEVEL

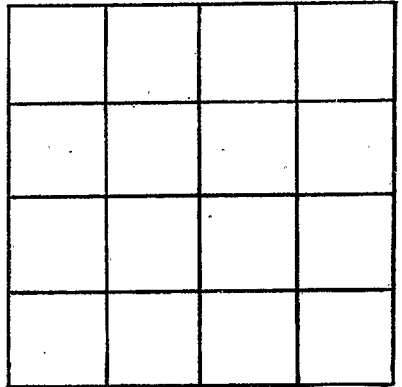

SECTION _____

Please indicate well location X.

ADDITIONAL INFORMATION

If more than one screen,
show locations of each on sketch.