

MISSISSIPPI DEPARTMENT OF NATURAL RESOURCES  
 Bureau of Land and Water Resources  
 Southport Mall  
 P.O. Box 10631  
 Jackson, Mississippi 39209  
**WATER WELL DRILLERS LOG**

LOWNDES
A
2057

October 17, 1985 Mid-South Drilling Lowndes  
 date well completed firm name county well located

LANDOWNER: Rodney Moore  
Rt. 4 Box 257B  
Columbus, Miss. 39702  
 (mailing address)

description of formations encountered

from to

clay	0	18
sand & gravel	18	30
clay	30	60
clay & sand	60	255

WELL LOCATION:

sec. 3 T. 18 N. R. 19 E  
 ③ W

\_\_\_\_\_ miles \_\_\_\_\_ of \_\_\_\_\_  
 (distance) (direction) (nearest town)

WELL PURPOSE: home  
 (home, irrigation, municipal, industrial)

WELL COMPLETION DATA:

(1) diameter (inches) 4"  
 (2) total depth (feet) 255'  
 (3) static water level (feet) 105' below above  
 top of ground.

(4) casing PVC, 165',  
 (material) (depth)  
4" if telescope see back.  
 (size)

(5) screen \_\_\_\_\_  
 (length) (depth to top)

\_\_\_\_\_ (size) \_\_\_\_\_ (material)

(6) pump 1/2 \_\_\_\_\_  
 (HP) (yield gpm)


subm.  
 (type power)

(7) electric log \_\_\_\_\_  
 (yes or no)

\_\_\_\_\_ (organization running log)

(8) how well bottom plugged \_\_\_\_\_


DRILLERS REMARKS:

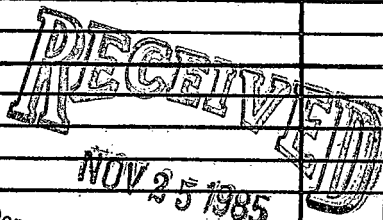

Department of Natural Resources  
 Bureau of Land & Water Resources

If well telescopes please sketch and show depths.

GROUND LEVEL

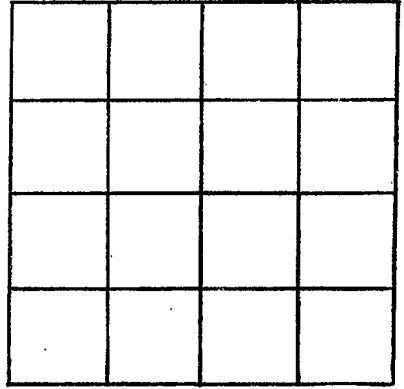

SECTION \_\_\_\_\_

Please indicate well location X.

ADDITIONAL INFORMATION

If more than one screen,  
show locations of each on sketch.