

MISSISSIPPI DEPARTMENT OF NATURAL RESOURCES

Bureau of Land and Water Resources

Southport Mall

P.O. Box 10631

Jackson, Mississippi 39209

WATER WELL DRILLERS LOG

LOWNDES
H
2058

May 22 1986 Mid South Drilling Company Lowndes  
 date well completed firm name county well located


LANDOWNER:	description of formations encountered	from	to
Cassie Freeman			
O. C. Electric			
2002 4th Ave. North	clay	0	6
Columbus, MS 39701	sand and gravel	6	12
(mailing address)	clay	12	45
WELL LOCATION:	clay and sand	45	60
sec. 29 T. 18S N. R. 19E S. W.	clay	60	70
miles in X of New Hope	clay and sand	70	75
(distance) (direction) (nearest town)	sand	75	88
WELL PURPOSE: home	clay	88	90
(home, irrigation, municipal, industrial)	sand	90	98
WELL COMPLETION DATA:	clay	98	105
(1) diameter (inches) 4	sand and clay	105	120
(2) total depth (feet) 270	clay	120	160
(3) static water level (feet) 115 below top of ground.	clay and sand	160	165
(4) casing PVC, 160 (material) (depth)	clay	165	175
4" (size) if telescope see back.	sand	175	180
(5) screen none (length) (depth to top)	clay	180	215
(size) (material)	sand	215	225
(6) pump none (HP) (yield gpm)	clay	225	230
(type power)	sand	230	243
(7) electric log no (yes or no)	clay	243	268
none (organization running log)	sand	268	270
(8) how well bottom plugged open			
DRILLERS REMARKS:			

RECEIVED  
 JUN 03 1986

Department of Natural Resources  
 Bureau of Land and Water Resources

If well telescopes please sketch and show depths.

GROUND LEVEL

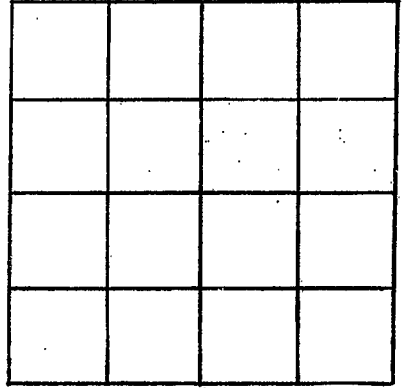

SECTION \_\_\_\_\_

Please indicate well location X.

ADDITIONAL INFORMATION

If more than one screen,  
show locations of each on sketch.