

LOWNDES  
H  
2089

MISSISSIPPI DEPARTMENT OF NATURAL RESOURCES  
Bureau of Land and Water Resources  
Southport Mall  
P.O. Box 10631  
Jackson, Mississippi 39209  
WATER WELL DRILLERS LOG

5-21-86 19 Clardy Well Drilling Lowndes  
date well completed firm name county well located

LANDOWNER: Church of Christ  
1828 10th Ave. No.  
Columbus, Ms.  
(mailing address)

WELL LOCATION:  
sec. 31 T 18 N R. 19 E  
3 miles SE of Col.  
(distance) (direction) (nearest town)

WELL PURPOSE: Church  
(home, irrigation, municipal, industrial)

WELL COMPLETION DATA:  
(1) diameter (inches) 4"  
(2) total depth (feet) 168 1/2  
(3) static water level (feet) 35 below top of ground.  
(4) casing PVC 79'  
(material) (depth)  
4" if telescope see back.  
(size)  
(5) screen \_\_\_\_\_  
(length) (depth to top)  
(size) (material)  
(6) pump 1/2 900 gph  
(HP) (yield gph)  
elec  
(type power)  
(7) electric log no  
(yes or no)  
(organization running log)  
(8) how well bottom plugged \_\_\_\_\_

description of formations encountered	from	to
Brown Clay	0	10
Agard & Gabel	10	28
Blue Clay	28	71
Causing Clay	71	74
Hard Clay	74	88
gummy clay	88	93
rock 3"		
blue clay	93	104
sandy clay	104	115
sand	115	123
sandy clay	123	131 1/2
rock 6"		
sandy clay	132	134
rock 6"		
sand	134 1/2	168 1/2
rock	168 1/2	


RECEIVED  
JUN 24 1986

Department of Natural Resources  
Bureau of Land & Water Resources

DRILLERS REMARKS:

If well telescopes please sketch and show depths.

GROUND LEVEL

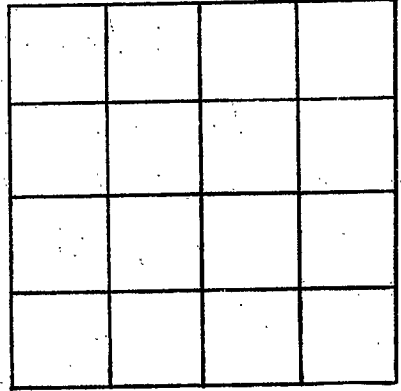

SECTION \_\_\_\_\_

Please indicate well location X.

ADDITIONAL INFORMATION

If more than one screen,  
show locations of each on sketch.