

MISSISSIPPI DEPARTMENT OF NATURAL RESOURCES


Bureau of Land and Water Resources

Southport Mall

P.O. Box 10631

Jackson, Mississippi 39209

WATER WELL DRILLERS LOG

LOWNDES

 HA060

6/27/86
 date well completed

Clardy Well Drilling Lowndes
 firm name county well located

LANDOWNER: Jerry Washington
 Ward Rd -
 Cols, Miss.
 (mailing address)

WELL LOCATION:
 sec. 18 T. 18 N. R. 17 E. W. 6
 1/2 miles E of Cols
 (distance) (direction) (nearest town)

WELL PURPOSE: home
 (home, irrigation, municipal, industrial)

WELL COMPLETION DATA:

- (1) diameter (inches) 4"
- (2) total depth (feet) 120'
- (3) static water level (feet) 14' below top of ground.
- (4) casing PVC 71' (material) (depth)
 4" (size) if telescope see back.
- (5) screen (length) (depth to top)
 (size) (material)
- (6) pump (HP) (yield gpm)
 (type power)
- (7) electric log no (yes or no)
 (organization running log)
- (8) how well bottom plugged

Description of formations encountered	from	to
Brown Clay	0	4
Sand & gravel	4	29
blue clay	29	33
sandy clay	33	41 1/2
rock	41 1/2	42
good clay	42	50
sandy clay	50	59 1/2
rock 3"		
sandy clay	59 1/2	66
good clay	66	70
sandy clay	70	85
rock	85	85 1/2
sandy clay	85 1/2	87
rocky	87	90
sandy	90	119
hard clay	119	120

RECEIVED


AUG 01 1986

Department of Natural Resources
 Bureau of Land and Water Resources

DRILLERS REMARKS:

If well telescopes please sketch and show depths.

GROUND LEVEL

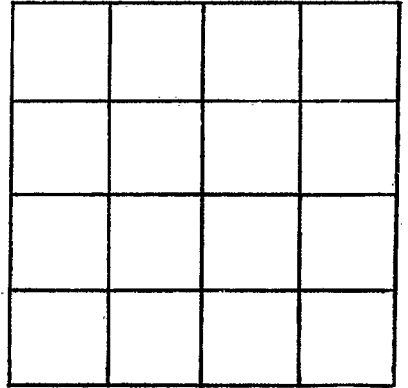

SECTION _____

Please indicate well location X.

ADDITIONAL INFORMATION

If more than one screen,
show locations of each on sketch.