

Lowndes  
H 2062

MISSISSIPPI DEPARTMENT OF NATURAL RESOURCES  
Bureau of Land and Water Resources  
Southport Mall  
P.O. Box 10631  
Jackson, Mississippi 39209  
**WATER WELL DRILLERS LOG**

9-27-86 Clardy Well Drilling Lowndes  
date well completed 19 firm name county well located

LANDOWNER: Calvary Christian School 311 Tuscaloosa Rd. Columbus, Miss. (mailing address)	Description of formations encountered	from	to
<b>WELL LOCATION:</b> sec. <u>18</u> T <u>18</u> R <u>12</u> E (distance) miles (direction) of (nearest town) <b>WELL PURPOSE:</b> <u>home</u> (home, irrigation, municipal, industrial) <b>WELL COMPLETION DATA:</b> (1) diameter (inches) <u>4"</u> (2) total depth (feet) <u>171'</u> (3) static water level (feet) <u>18'</u> below top of ground. (4) casing <u>PVC</u> <u>75'</u> (material) (depth) <u>4"</u> (size) if telescope see back. (5) screen _____ (length) (depth to top) (size) (material) (6) pump _____ (HP) (yield gpm) (type power) (7) electric log _____ (yes or no) (organization running log) (8) how well bottom plugged _____	Brown clay	0	11
	Sand & gravel	11	30
	Sandy Clay	30	45
	Good clay	45	57½
	Rock	57½	58
	good clay	58	86
	rock	86	86½
	good clay	86½	152
	Sand	152	170
	Clay	170	171

RECEIVED


OCT 15 1986

Department of Natural Resources  
Bureau of Land & Water Resources

DRILLERS REMARKS:

If well telescopes please sketch and show depths.

GROUND LEVEL

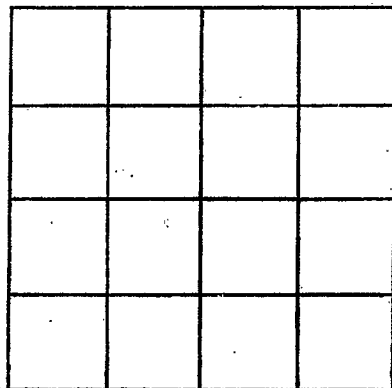

SECTION \_\_\_\_\_

Please indicate well location X.

ADDITIONAL INFORMATION

If more than one screen,  
show locations of each on sketch.