

# MISSISSIPPI DEPARTMENT OF NATURAL RESOURCES

Bureau of Land and Water Resources

COUNTY WELL LOCATED  
**Hinds**

WELL NUMBER  
**H 2067**

DATE WELL COMPLETED  
**8/3/88**

PERMIT NUMBER

NAME OF DRILLING FIRM  
**Clardy Well Drilling**  
**Columbus, Mo. 39702**

P.O. Box 10631  
Jackson, Mississippi 39209  
WATER WELL DRILLERS LOG

NAME & MAILING ADDRESS OF LANDOWNER  
**Joe Hendrix**  
**Rt. 10 Box 255**  
**Columbus, Mo.**

WELL LOCATION: SEC **15** TOWNSHIP **18 N** RANGE **19 E**

DISTANCE **3 1/2** Miles DIRECTION **East** of NEAREST TOWN **Columbus, Mo.**

OTHER LANDMARK  
**Home**

WELL PURPOSE: Home, Irrigation, Municipal, Industrial, Fish Pond, etc.  
**Home**

**PUMP DATA**

PUMP TYPE (Circle One):  
 Submersible    Turbine,    Jet    Flowing Well,  
Other (Describe) \_\_\_\_\_

POWER TYPE (Circle One):  
 Electric    Tractor,    Diesel,    Gasoline,    Butane,  
Other (Describe) \_\_\_\_\_

Pump Capacity (GPM) **900** No. of Stages **12** Setting Depth **170** FT.

PUMP TEST  
Well yielded **900** GPM with  
a drawdown of \_\_\_\_\_ ft.  
after \_\_\_\_\_ hours of pumping

**WELL DATA**

Well Depth <b>245'</b>	Casing Diameter (In.) <b>4"</b>	Casing Length (Ft.) <b>175</b>
Type of Casing <b>PVC</b>	Hole Depth <b>118</b>	Depth to Static Water Level <b>118</b>

TYPE OF COMPLETION: (Circle One or More):  
Gravel Packed, Underreamed, Telescoped,  
Natural Development, Open Hole, Other  
(Describe) \_\_\_\_\_

Top of Lap Pipe or Reduction in Casing  
FEET    IF TELESCOPED OR MORE THAN ONE SCREEN: USE BACK PAGE

**LOG DATA**

TYPE OF LOG RUN (Circle One):  
 No Log Run,     Electric,     Gamma Ray,     Density,     Sonic,     Neutron,  
Other (Describe) \_\_\_\_\_

Name of Organization Running Log

**SCREEN DATA**

Diameter - Inches <b>2</b>	Length - Feet <b>50</b>	Slot Size - Inches <b>.013</b>
Screen Type <b>PVC</b>	Depth to Bottom - Feet	

**GEOLOGIC DATA (Office Use Only)**

Surface Elev.	Geologic Unit	Unit Thickness	Depth to Top
Subs. SWL	Log Analysis	Analysis	Analysis

RECEIVED


SEP 19 1988

**Department of Natural Resources**  
**Bureau of Land & Water Resources**

DESCRIPTION OF FORMATIONS ENCOUNTERED	FROM	TO	FORMATIONS (Continued)	FROM	TO
Red clay	0	12	sandy blue clay	153 1/2	156
sand + gravel	12	25	Blue clay	156	166
Brown clay	25	35	fine sand streak	166	182
sandy clay	35	42	Blue clay	182	194
Blue clay	42	62	Brown sandy cl.	194	200
sandy clay	62	133	sandy blue clay	200	204
Blue clay	133	137	sand streak	204	242
sandy blue clay	137	148 1/2	Blue clay	242	245
Rock	148 1/2	149			
sandy blue clay	149	151			
Blue clay	151	153 1/2			

IF MORE SPACE IS NEEDED, USE BACK

If well telescopes, please sketch and show depths.

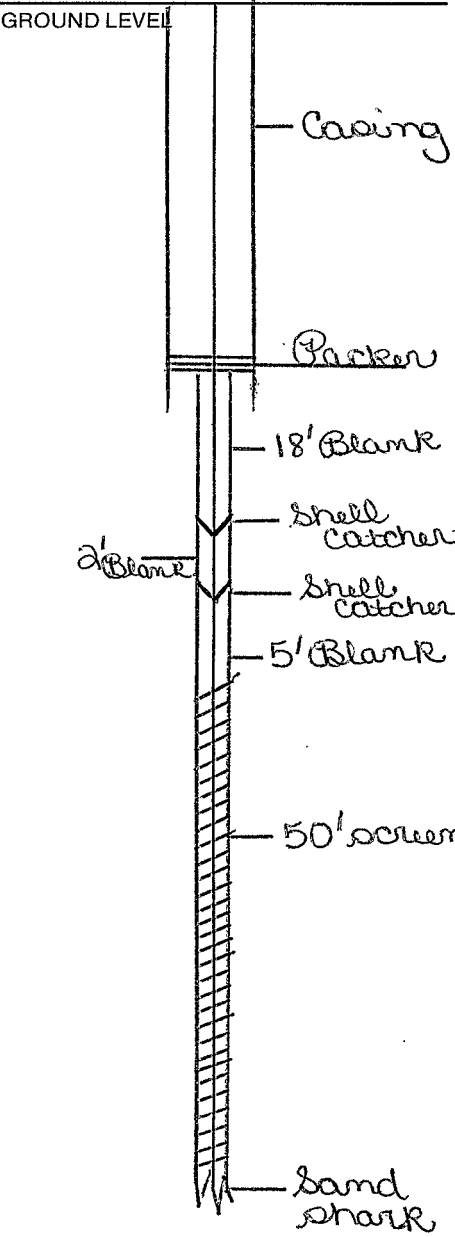


SECTION \_\_\_\_\_

Please indicate well location X.

ADDITIONAL INFORMATION

---

---

If more than one screen, show location of each on sketch.