

MISSISSIPPI DEPARTMENT OF ENVIRONMENTAL QUALITY

Office of Land and Water Resources

P. O. Box 10631
Jackson, MS 39289-0631
WATER WELL DRILLERS LOG

COUNTY WELL LOCATED Bowling
WELL NUMBER CODED A 2080
DATE WELL COMPLETED 8/3/93

PERMIT NUMBER
NAME OF DRILLING FIRM Clardy Well Columbus, Ind

NAME & MAILING ADDRESS OF LANDOWNER Edward Whitton 1073 Phac Davio R. Columbus, Ind		
WELL LOCATION: SEC	TOWNSHIP	RANGE
26	18 S	19 E
DISTANCE	DIRECTION	NEAREST TOWN
4 1/2 Miles	East of Columbus	
OTHER LANDMARK		
WELL PURPOSE: Home, Irrigation, Municipal, Industrial, Fish Pond, etc. Home		

PUMP DATA		
PUMP TYPE (Circle One): Submersible Turbine, Jet, Flowing Well, Other (Describe)		
POWER TYPE (Circle One): Electric , Tractor, Diesel, Gasoline, Butane, Other (Describe) H/P 3/4		
Pump Capacity (GPM) 900	No. of Stages 12	Setting Depth 132 FT.
PUMP TEST Well yielded _____ GPM with a drawdown of _____ ft. after _____ hours of pumping		

WELL DATA		
Well Depth 190'	Casing Diameter (In.) 4"	Casing Length (Ft.) 143 1/2'
Type of Casing PVC	Hole Depth	Depth to Static Water Level 100'

LOG DATA	
TYPE OF LOG RUN (Circle One): No Log Run, Electric, Gamma Ray, Density, Sonic, Neutron, Other (Describe)	
Name of Organization Running Log	

TYPE OF COMPLETION: (Circle One or More): Gravel Packed, Underreamed, Telescoped , Natural Development, Open Hole, Other (Describe)	
WELL GROUTED TO A DEPTH OF _____ FEET Type Grout (circle one): Cement, Bentonite, or Mix	

GEOLOGIC DATA (Office Use Only)			
Surface Elev.	Geologic Unit	Well Thickness	Depth to Top
Subs. SWL	Date	Analysis	Actual Test


SCREEN DATA		
Diameter - Inches 2"	Length - Feet 40	Slot Size - Inches .012
Screen Type PVC	Depth to Bottom - Feet	

Driller's Remarks	AUG 11 1993
Dept. of Environmental Quality Office of Land & Water Resources	

DESCRIPTION OF FORMATIONS ENCOUNTERED	FROM	TO	FORMATIONS (Continued)	FROM	TO
Red sandy clay	0	13	Clay	104	110 1/2
Sand	13	18	sm. rock	110 1/2	
Red sandy cl.	18	22	Clay	110 1/2	121
Blue clay	22	33	sm. rock	121	
sandy clay	33	48	Clay	121	125
clay	48	65	sandy clay	125	147
sandy clay	65	68	sand & rock	147	152
Clay	68	74	Clay	152	159
sandy clay	74	94	sm. rock	159	
Clay	94	102	Clay	159	162
Rocky	102	104			

IF MORE SPACE IS NEEDED, USE BACK

If well telescopes please sketch and show depths.

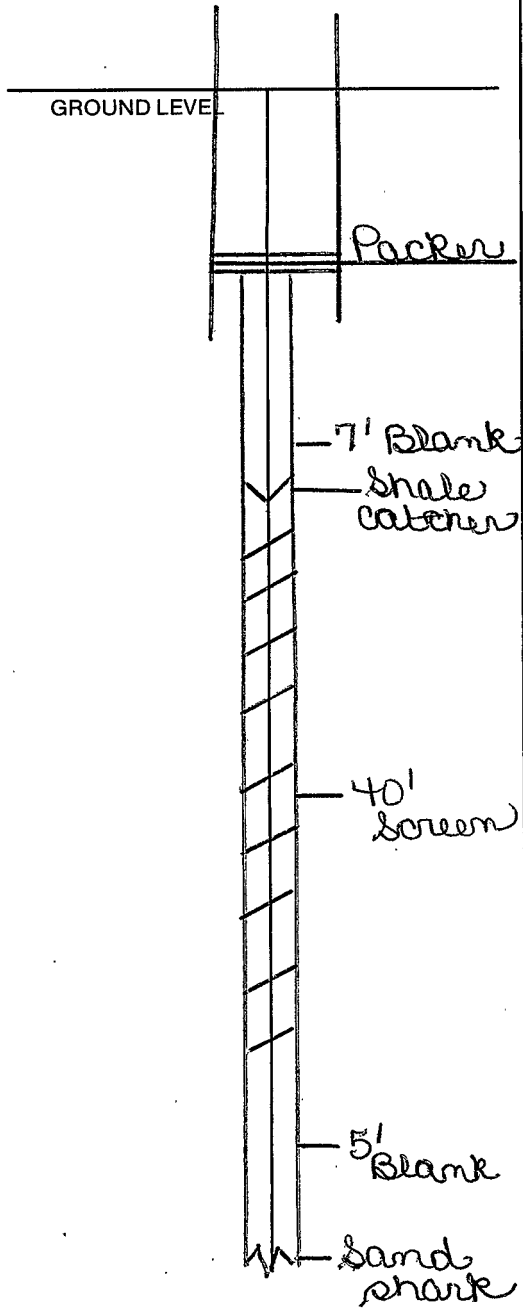

SECTION: _____

Please indicate well location X.

ADDITIONAL INFORMATION

Sandy Clay	162-171
Sandstone	171-179
Clay	179-190

If more than one screen, show location of each on sketch.