

J

WATER WELL DRILLERS LOG

9-21-62

Date: 9-21, 1962, Driller: E. B. Norwood County Norfolk

Adrian, Miss. (Name)

(1) Owner of Land: Tom Perry Jr.

(Name)

Adrian, Miss.

(Address)

(2) Location: 1/4, 1/4, Sec.     T.     R.    

E miles

(distance)

(direction)

of Adrian

(Nearest Town)

(3) Topography: Flat

(Hilly)

(Flat)

(Level)

(4) Purpose of Well: Home use

(Domestic Irrigation  
Municipal, Industrial, Other)

Description & Color of Materials -  
Sand, Clay, Red Clay, Shell, etc.

Thick-  
ness  
Feet

Depth  
Feet

Clay	0	9
Blue rock	9	386
sand	386	453
Shale	453	461
sand	461	475
Shale	475	523
sand	523	565

Information upon completion of well:

(1) Diameter 4 inches.

(2) Total Depth 565 feet.

(3) Water Level 63 feet below top of ground.

(4) Cased to 18', Size 4"

(5) Screen: Size preferred pipe Length 21'


(6) Were any formations sealed against pollution?

    yes,     no.

If YES depth of formation    

Why    

Drillers Remarks:    

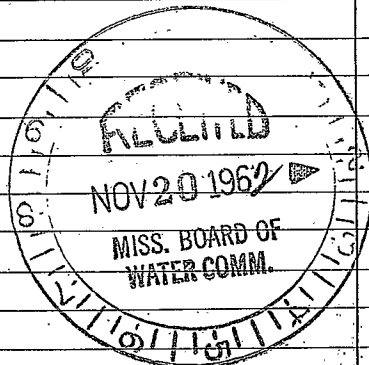

(Use Back Side)

Well No.

