

Lowndes  
J15  
10-28-71

MISSISSIPPI  
 BOARD OF WATER COMMISSIONERS  
 416 North State Street  
 Jackson, Mississippi 39201

**CODED**

WATER WELL DRILLERS LOG  
 HERMAN ECHOLS

*Lowndes*

10/28 1971  
 date well completed



Pump & Well Service  
 firm name  
 Starkville, Miss.

county well located

LANDOWNER:

*Rebecca Johnson*  
*Ortervia, Miss*  
 (mailing address)

Phone 323-5111  
 description of formations  
 encountered

from to

<i>Clay</i>	<i>0</i>	<i>12</i>
<i>Clay</i>	<i>12</i>	<i>370</i>
<i>Small White Sand</i>	<i>370</i>	<i>410</i>
<i>Muddy Sand Rock</i>	<i>410</i>	<i>480</i>

WELL LOCATION:

sec. 25 T. 18 N. R. 16 E.  
 S W  
4 miles South of Ortervia  
 (distance) (direction) (nearest town)

WELL PURPOSE: Home  
 (home, irrigation, municipal, industrial)

WELL COMPLETION DATA:

- diameter (inches) 5"
- total depth (feet) 490
- static water level (feet) 100 below above top of ground.
- casing 5" 21  
 (material) (depth)  
 (size) if telescope see back.
- screen (length) (depth to top)  
 (size) (material)
- pump 1 3  
 (HP) (yield gpm)  
Elec  
 (type power)
- electric log (yes or no)
- (organization running log)
- how well bottom plugged

**CODED**


NOV 2 - 1971

MISS. Bd. of  
 WATER COMM.

DRILLERS REMARKS:

If well telescopes please  
sketch and show depths.

GROUND LEVEL

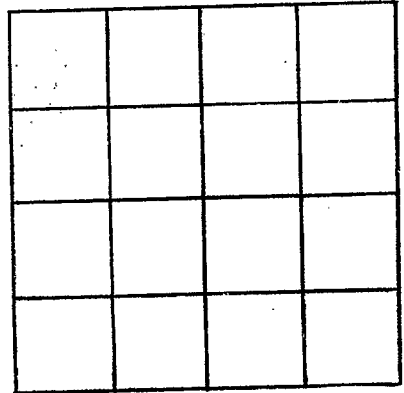

SECTION \_\_\_\_\_

Please indicate well location X.

ADDITIONAL INFORMATION

If more than one screen,  
show locations of each on sketch.