

Make Schedule

MISSISSIPPI BOARD OF WATER COMMISSIONERS
416 North State Street
Jackson, Mississippi 39201

CODED 1972

WATER WELL DRILLERS LOG

Lowndes
J 16
2-29-72

Feb 29 1972
date well completed

J W Webb & Sons
firm name

Lowndes
county well located

LANDOWNER:	description of formations encountered	from	to
Golden Triangle	CLAY & TOPSOIL	0	18
REGIONAL AIRPORT (mailing address)	BLUE ROCK	18	260
	BLUE-GRAY SAND	260	460
	BLUE ROCK & SHELLS	460	520
	BLUE GRAY SAND	520	625
	Blue Rock	625	750

WELL LOCATION:
sec. 1 T. 18N S. R. 16E W.
7 miles W of Columbus
(distance) (direction) (nearest town)

WELL PURPOSE: AIRPORT
(home, irrigation, municipal, industrial)

WELL COMPLETION DATA:

(1) diameter (inches) 10
(2) total depth (feet) 610
(3) static water level (feet) 112 ^{below} above top of ground.
(4) casing Steel, 460'
(material) (depth)
(size) If telescope see back.
(5) screen 50', 420'
(length) (depth to top)
6", SP
(size) (material)
(6) pump 25 146
(HP) (yield gpm)
Elec
(type power)
(7) electric log Yes
(yes or no)
U.S.G.S.
(organization running log)
(8) how well bottom plugged BRONZE
BACK WASH VALVE


DRILLERS REMARKS:

CODED

(F)

If well telescopes please sketch and show depths.

GROUND LEVEL

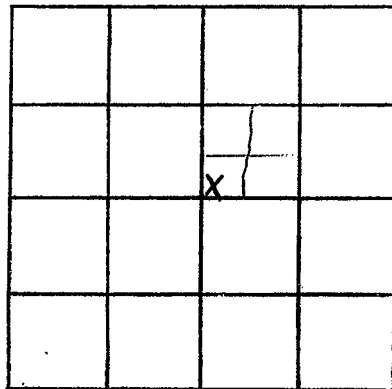

SECTION _____

Please indicate well location X.

ADDITIONAL INFORMATION

If more than one screen,
show locations of each on sketch.