

**LOWNDES**  
**J 18**  
**7-12-72**

MISSISSIPPI  
 BOARD OF WATER COMMISSIONERS  
 416 North State Street  
 Jackson, Mississippi 39201

WATER WELL DRILLERS LOG

**CODED**

7-12  
 date well completed

1972 Herman Echeverria  
 firm name


Lowndes  
 county well located

LANDOWNER: <u>Macey Bros</u>	description of formations encountered	from	to
<p><u>Artesia, Miss.</u>            (mailing address)</p>	<p>Top Soil            Chalk            Sand &amp; Rock</p>	<p>0            5'            520'</p>	<p>5'            520'            660'</p>
<p>WELL LOCATION:            sec <u>32</u> T <u>18</u> N R <u>16</u> E  <u>2</u> miles <u>S</u> of <u>Artesia</u>            (distance) (direction) (nearest town)</p>			
<p>WELL PURPOSE:            (home, irrigation, municipal, industrial)</p>			
<p>WELL COMPLETION DATA:</p>			
<p>(1) diameter (inches) <u>5"</u></p>			
<p>(2) total depth (feet) <u>660'</u></p>			
<p>(3) static water level (feet) <u>90</u> below above top of ground.</p>			
<p>(4) casing <u>21' 5" casing</u>            (material) (depth)            (size) if telescope see back.</p>			
<p>(5) screen (length) (depth to top)            (size) (material)</p>			
<p>(6) pump <u>3/4</u> <u>10 Gal Min</u>            (HP) (yield gpm)  <u>Elec-</u>            (type power)</p>			
<p>(7) electric log <u>no</u>            (yes or no)            (organization running log)</p>			
<p>(8) how well bottom plugged</p>			
<p>DRILLERS REMARKS:</p>	<p><u>105' New 5/8\"/&gt; </u></p>		

OCT 20 1972

If well telescopes please sketch and show depths.

GROUND LEVEL

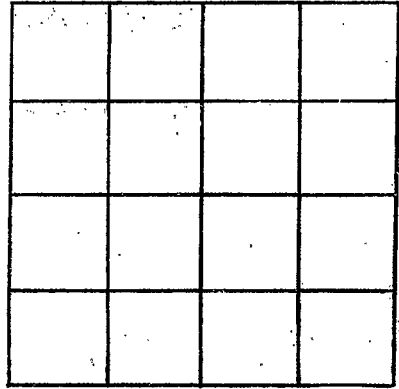

SECTION \_\_\_\_\_

Please indicate well location X.

ADDITIONAL INFORMATION

If more than one screen, show locations of each on sketch.