

LOWNDES
J 19
7-11-72


MISSISSIPPI
 BOARD OF WATER COMMISSIONERS
 416 North State Street
 Jackson, Mississippi 39201

WATER WELL DRILLERS LOG

7-11-72 19 ~~7-11-72~~ ~~Tom Wilburn~~ ~~Herman Echols~~ **Lowndes**
 date well completed firm name county well located

CODED

LANDOWNER:	description of formations encountered	from	to
<u>Tom Wilburn</u>			
<u>Artesia, Miss</u> (mailing address)	<u>Top Soil</u>	<u>0</u>	<u>10'</u>
	<u>Clay</u>	<u>10'</u>	<u>385'</u>
	<u>Sand & Rock</u>	<u>385'</u>	<u>485'</u>
WELL LOCATION:			
sec <u>27</u> T <u>18</u> N R <u>16</u> E			
<u>2</u> miles <u>SE</u> of <u>Artesia</u>			
(distance) (direction) (nearest town)			
WELL PURPOSE: (home, irrigation, municipal, industrial)			
WELL COMPLETION DATA:			
(1) diameter (inches)	<u>5"</u>		
(2) total depth (feet)	<u>485'</u>		
(3) static water level (feet)	<u>85</u> below top of ground.		
(4) casing (material)	<u>21' 5" casing</u>		
	(depth)		
	(size) if telescope see back.		
(5) screen (length)			
	(depth to top)		
	(size) (material)		
(6) pump <u>1 HP</u>	<u>15 gal. min</u>		
Sub. (HP)	(yield/gpm)		
<u>Elec</u>			
	(type power)		
(7) electric log <u>No</u>			
	(yes or no)		
	(organization running log)		
(8) how well bottom plugged			
DRILLERS REMARKS:			

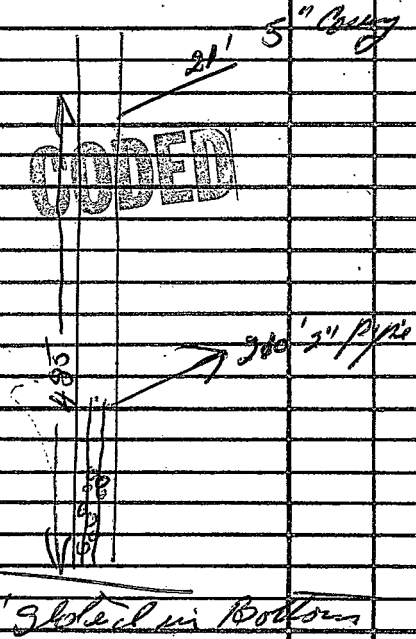


NOV 20 1972

MISS. Bd. Of WATER COMMISSIONERS

If well telescopes please sketch and show depths.

GROUND LEVEL

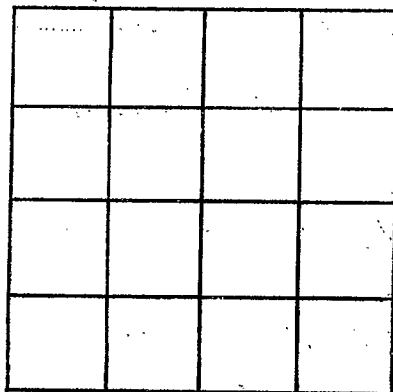

SECTION _____

Please indicate well location X.

ADDITIONAL INFORMATION

If more than one screen,
show locations of each on sketch.