

LOWNDES
J 22
3-3-73

MISSISSIPPI
 BOARD OF WATER COMMISSIONERS
 416 North State Street
 Jackson, Mississippi 39201

CODED

WATER WELL DRILLERS LOG

3/3 1973 Norman Echols Lowndes
 date well completed firm name county well located


LANDOWNER: <u>Mr. Smith</u>	description of formations encountered	from	to
<u>R7D#1</u>	<u>Red clay</u>	<u>0</u>	<u>18</u>
<u>Ortwin, Miss</u>	<u>lime & shell</u>	<u>18</u>	<u>320</u>
(mailing address)	<u>Sand & clay</u>	<u>320</u>	<u>1130</u>
WELL LOCATION:	<u>Clay some / Sand</u>	<u>420</u>	<u>440</u>
sec <u>25 T 18 N</u> R <u>16 E</u>			
<u>5</u> miles <u>East</u> of <u>Ortwin</u>			
(distance) (direction) (nearest town)			
WELL PURPOSE: (home, irrigation, municipal, industrial)			
WELL COMPLETION DATA:			
(1) diameter (inches) <u>5"</u>			
(2) total depth (feet) <u>440</u>			
(3) static water level (feet) <u>70</u> below above top of ground.			
(4) casing <u>5"</u> <u>21'</u> (material) (depth)			
_____ if telescope see back. (size)			
(5) screen _____ (length) (depth to top)			
_____ (size) _____ (material)			
(6) pump <u>1/2</u> <u>8</u> (HP) (yield gpm)			
<u>Electric</u> (type power)			
(7) electric log (yes or no) _____			
_____ (organization running log)			
(8) how well bottom plugged _____			
DRILLERS REMARKS:			

CODED

MAR 10 1973

If well telescopes please sketch and show depths.

GROUND LEVEL

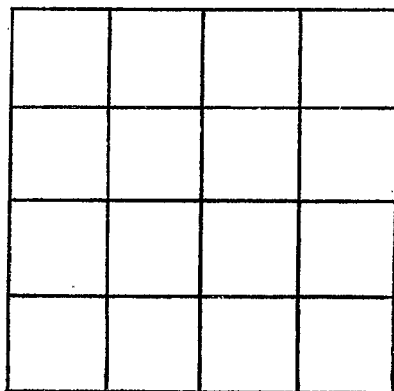

SECTION _____

Please indicate well location X.

ADDITIONAL INFORMATION

If more than one screen, show locations of each on sketch.