

STATE WELL REPORT

Part 1

Driller's Log

Mississippi Department of Environmental Quality
Office of Land and Water Resources
P.O. Box 2309
Jackson, MS 39225-2309
(601)961-5210
(601)360-0535 (fax)

For Office Use Only:

Well #: J42
Aquifer: _____
E-Log #: _____

County: Lauderdale Co
Permit #: None
Driller: T. B. Willis
Date drilling completed: 10/24/16

State Law requires that this report be prepared by the license holder responsible for the work and filed with the Department at the above address within 30 days of completion of drilling of the well or borehole.

Well Owner Information <small>(Landowner if borehole is not for a water well)</small>	Well or Borehole Location
Owner Name: <u>Harold Hudson</u>	Latitude: <u>N33°22.729</u> Longitude: <u>W88°36.556</u>
Mailing Address: <u>1488 Columbine Dr.</u>	<u>33-23-51</u> <u>88-36-36</u> Method of Lat/Long (check one): Conventional Survey _____
City: <u>Tupelo</u> State: <u>MS</u> Zip Code: <u>38801</u>	USGS quad _____, Hand-held GPS <input checked="" type="checkbox"/> , Survey-grade GPS _____
Telephone No. <u>(662) 678-0387</u>	<u>SE</u> $\frac{1}{4}$ <u>NW</u> $\frac{1}{4}$, Sec <u>27</u> T <u>18N</u> R <u>16E</u>
	<u>3</u> Miles <u>SE</u> of <u>Artesia, MS</u> (Distance) (Direction) (Nearest Town)

Well / Borehole Data
Date drilling started: <u>10/24/16</u> Date drilling completed: <u>10/24/16</u> Hole depth: <u>480</u> Hole diameter: <u>5"</u>
Location of the source of any surface water used for drilling: <u>Old well nearby</u>
Method of dosing and volume of Chlorine used in drilling and development: <u>1/2 gal / 1000 gal</u>
Logs run (circle all applicable): <input checked="" type="checkbox"/> No log run <input type="checkbox"/> Electric <input type="checkbox"/> Gamma Ray <input type="checkbox"/> Density <input type="checkbox"/> Sonic <input type="checkbox"/> Neutron <input type="checkbox"/> Other: _____
Name of organization running log(s): _____
Purpose of borehole (circle one): <input checked="" type="checkbox"/> Water Well <input type="checkbox"/> Geotechnical/Geological Investigation <input type="checkbox"/> Ground Source Heat Pump <input type="checkbox"/> Seismic Survey <input type="checkbox"/> Other (describe) _____
<i>If drilling is not related to water well construction, skip the remainder of this block</i>
Purpose of Well (circle all applicable): <input checked="" type="checkbox"/> Home <input type="checkbox"/> Industrial <input type="checkbox"/> Public Supply <input type="checkbox"/> Irrigation <input type="checkbox"/> Fish Culture
Other (describe): _____
If a flowing well, method of flow regulation: Valve _____ Other (describe) _____
Static Water Level: <u>154</u> feet [above or below] land surface Date measured: <u>10/24/16</u> <small>(circle one)</small>
Method of measurement (circle one): <input checked="" type="checkbox"/> Steel tape <input type="checkbox"/> Electric tape <input type="checkbox"/> Air line <input type="checkbox"/> Other (describe): _____
Well depth: _____ Well grouted to a depth of: _____ feet Type of grout (circle one): Neat Cement <input type="checkbox"/> Bentonite <input type="checkbox"/> Mix
Casing length: <u>60</u> feet Casing diameter: <u>5</u> inches Type of casing: <u>PVC</u>
Screen length: <u>100</u> feet Screen diameter: <u>2</u> inches Type of screen: <u>PVC</u>
Screen slot size: <u>.025</u> inches Setting depth: From <u>380</u> feet to <u>480</u> feet
Type of completion (circle all applicable): Gravel packed <input type="checkbox"/> Underreamed <input type="checkbox"/> Open hole <input checked="" type="checkbox"/> Natural Development
Other (describe): _____
Top of lap pipe or reduction in casing: <u>340ft</u> feet
<i>If telescoped or more than one screen, describe on next page</i>


RECEIVED
 MAR 01 2017
 BY OLWR

County: Lauderdale Co
 Permit #: None

For Office Use Only:
 Well #: JA2

The sketch below only required for water wells

If well telescopes, show depths on sketch.

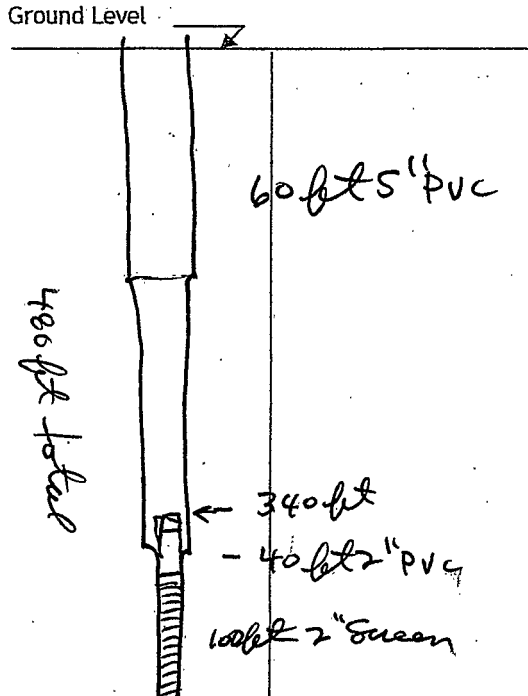

If more than one screen, show location of each on sketch

Description of formations encountered must be provided for all wells and boreholes, unless specifically exempted by regulations


Description of Formations Encountered	From (depth) Ground level	To (depth)
Top Clay	0	12
Timberock	12	385
Entaw Sand	385	480

Sketch the property layout and include the following:

- 1) the well location
- 2) any permanent structures on the property that may aid in locating the well
- 3) any roads, power lines, or other items that may aid in locating the property and the well
- 4) north arrow

approx. 3 mi SE of
 Artesia, Ms.

5475 Gilmer Willburn Rd
 Gilmer Willburn

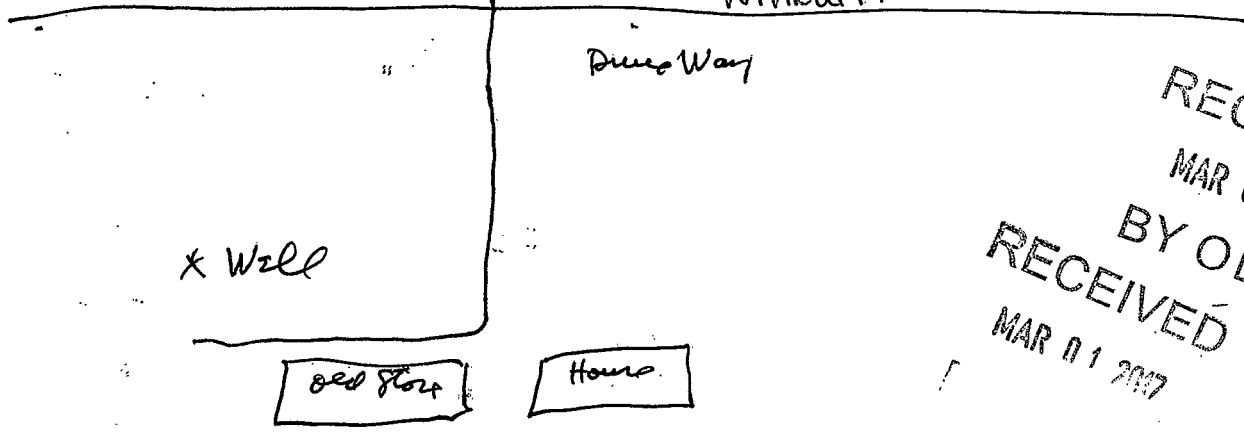

RECEIVED
 MAR 01 2017
 BY OLWR
 RECEIVED
 MAR 01 2017

Landowner Name: _____

I HEREBY CERTIFY that the well/borehole was drilled, constructed, and completed in accordance with all applicable requirements of the Mississippi Department of Environmental Quality and the Mississippi Department of Health regulations, if applicable, and state laws.

Thomas B. Willin 0627 11/18/16 Thomas B. Willin
 Print Name of Responsible Licensee and License No. Date Signature of Licensee

STATE WELL REPORT

Part 2

Pump Installer's Completion Report
 Mississippi Department of Environmental Quality
 Office of Land and Water Resources
 P.O. Box 2309
 Jackson, MS 39225-2309
 (601)961-5210
 (601) 360-0535 (fax)

For Office Use Only:

Well #: JA2

Aquifer: _____

County: Jordan
 Permit #: none
 Driller: T.B. Wellm
 Date completed: 10/24/16
Copy information from block on Part 1

This part of the report must be completed by a licensed water well contractor or a licensed pump installer. A copy of Part 1 of the report must be attached and both parts filed with the Department at the above address within 30 days of well completion.

Well Owner Information	Well Location
Owner Name: <u>Harold Hudson</u>	Latitude: <u>33°22'72"</u> Longitude: <u>W88°36'556"</u>
Mailing Address: <u>1488 Columbus Dr.</u>	Method of Lat/Long (check one): Conventional Survey _____, <u>33-23-51</u> <u>88-36-36</u> USGS quad _____, Hand-held GPS <input checked="" type="checkbox"/> , Survey-grade GPS _____
<u>Tupelo</u> <u>Ms.</u> <u>38801</u> City State Zip Code	<u>SE 1/4 NW 1/4, Sec 27 T 18N R 16E</u>
Telephone No. <u>(662) 678-0387</u>	<u>3</u> Miles <u>SE</u> of <u>Artesia, Ms.</u> (Distance) (Direction) (Nearest Town)

Pump Type (circle one)

Submersible Turbine Air Lift Centrifugal Flowing Well Jet Piston Rotary Other (describe): _____

Date Pump Installed: 10/24/16 Rated Pump Capacity: 15 Gallons Per Minute

Is This Pump (circle one): New Repaired Replacement

Power Type (circle one)

Electric Diesel Gasoline Natural Gas Tractor PTO Windmill Other (describe): _____

Horse Power Rating of Motor: 1 Setting Depth: 200 feet Number of Stages: _____

Pump Test Data for Non Flowing Well

Date Well Tested: _____ Duration of Pump Test (minimum 4 hours): _____ hours

Static Water Level (A): 154 Feet Below Land Surface Pumping Water Level (B): _____ Feet Below Land Surface

Drawdown [(B) - (A)]: _____ Feet Below Land Surface Test Pumping Rate: _____ Gallons Per Minute

Method of measurement (circle one): Steel tape Electric tape Air line Other (describe): _____

Pump Test Data for Flowing Well

Measured shut in head: _____ feet.

Well yielded 15 GPM with a drawdown of _____ feet after _____ hours of pumping

Meter Installation

Meter Manufacturer: _____ Meter Serial Number: _____

Meter Model Number/Name: _____ Type of Meter: _____

Totalizer Register Unit and Multiplier Factor (AF x .001, gal x 1000, etc): _____

Installation Date: _____ Meter installed by: _____

Is This Meter (circle one): New Repaired Replacement

Important: By submitting the above information you are certifying that this meter was installed to manufacturer standards. For agricultural wells, a list of approved meters is on the MDEQ website.

I HEREBY CERTIFY that the above statements are true to the best of my knowledge.

Print Name of Pump Installer and License No. (if applicable) _____ Date _____ Signature of Pump Installer _____

RECEIVED
 MAR 01 2017
 BY OLWR