

LOWNDES
J 2000
June 1977

MISSISSIPPI
BOARD OF WATER COMMISSIONERS
416 North State Street
Jackson, Mississippi 39201

WATER WELL DRILLERS LOG


June 1977 date well completed
HERMAN ECHOLS firm name
Lumbis county well located

LANDOWNER: <u>R J SMITH</u>	description of formations encountered	from	to
<u>ARTESIA MISS</u> (mailing address)	<u>Red clay</u> <u>Chalk</u> <u>Sand</u>	<u>0</u> <u>15</u> <u>350</u>	<u>15</u> <u>350</u> <u>500</u>
WELL LOCATION: sec. <u>8</u> T. <u>18</u> (N) S R. <u>16</u> (E) W <u>NORTH</u> miles <u>2</u> of <u>Ontosa</u> (distance) (direction) (nearest town)			
WELL PURPOSE: <u>HOME</u> (home, irrigation, municipal, industrial)			
WELL COMPLETION DATA:			
(1) diameter (inches) <u>4 1/2</u>			
(2) total depth (feet) <u>500</u>			
(3) static water level (feet) <u>120</u> below above top of ground.			
(4) casing <u>6" Plastic</u> <u>20'</u> (material) (depth)			
_____ (size) if telescope see back.			
(5) screen _____ (length) (depth to top)			
_____ (size) (material)			
(6) pump <u>1/2</u> <u>10</u> (HP) (yield gpm)			
<u>CLX</u> (type power)			
(7) electric log _____ (yes or no)			
_____ (organization running log)			
(8) how well bottom plugged <u>0</u>			
DRILLERS REMARKS:			

RECEIVED
AUG - 1 1977

If well telescopes please
sketch and show depths.

GROUND LEVEL

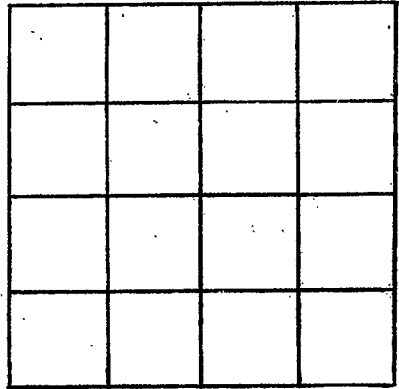

SECTION _____

Please indicate well location X.

ADDITIONAL INFORMATION

If more than one screen,
show locations of each on sketch.