

MISSISSIPPI DEPARTMENT OF NATURAL RESOURCES

Bureau of Land and Water Resources

Southport Mall

P.O. Box 10631

Jackson, Mississippi 39209

WATER WELL DRILLERS LOG

Landes
J
2001

10-28
 date well completed

1982 Clardy Well Drilling Landes
 firm name county well located

LANDOWNER: Robert Honsinger
Artesia, Miss.
P.O. Box 127 39736
 (mailing address)

WELL LOCATION:
 sec. 9 T 18 N 16 E
1 miles NE of Artesia
 (distance) (direction) (nearest town)

WELL PURPOSE: home
 (home, irrigation, municipal, industrial)

WELL COMPLETION DATA:

(1) diameter (inches) 4"

(2) total depth (feet) 428'

(3) static water level (feet) 133' below top of ground.

(4) casing PVC 210' 4"
 (material) (depth)
1432"
 (size) if telescope see back.

(5) screen 20
 (length) (depth to top)

2
 (size) (material)

(6) pump 1 1/2 1200 gph.
 (HP) (yield gpm)

elec
 (type power)

(7) electric log No
 (yes or no)

(organization running log)

(8) how well bottom plugged

description of formations encountered	from	to
lime rock	9	16
blue clay (hard)	16	68
gummy clay	68	140
rock	140	141
gummy clay	141	143
rock	143	143 1/2
gummy clay	143 1/2	187
sandy clay	187	188
clay	188	195 1/2
rock	195 1/2	
clay	195 1/2	198
sandy clay	198	199
clay	199	200
sand	200	201 1/2
clay	201 1/2	211
sw. rock	211	
clay	211 1/2	233
sandy clay	233	242
fine sandy clay	242	267
hard clay	267	320
fine sandy clay	320	327
fine sand	327	348
sandy clay	348	355
good sand	355	368
rock	368	370
good sand	370	377
rock	377	378
good sand	378	390
rock	390	390 1/2
good sand	390 1/2	404
sandy clay	404	408
good sand	408	424
DEPT. OF NATURAL RESOURCES	424	427
BUREAU OF LAND & WATER RESOURCES	427	428
hard clay	427	428

NOV 30 1982

DRILLERS REMARKS:

RECEIVED

If well telescopes please sketch and show depths.

GROUND LEVEL


210' - 4"

11 1/2'

154 1/2' - 2"

70' - 2"

2" 5"

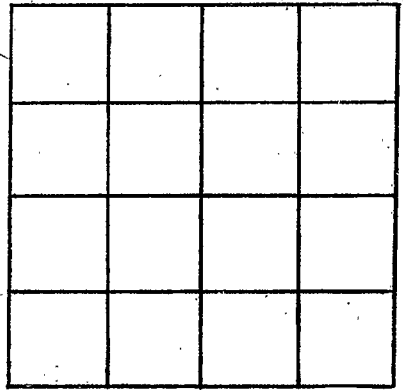

SECTION _____

Please indicate well location X.

ADDITIONAL INFORMATION

If more than one screen, show locations of each on sketch.