

Lowder  
J 2007

MISSISSIPPI DEPARTMENT OF NATURAL RESOURCES  
 Bureau of Land and Water Resources  
 Southport Mall  
 P.O. Box 10631  
 Jackson, Mississippi 39209  
 WATER WELL DRILLERS LOG

3-25 1983 Clardy Well Drilling Lowder  
 date well completed                      firm name                      county well located

LANDOWNER: Walker Sherry  
Artesia, Miss.

description of formations encountered	from	to
	Line rock	9

(mailing address)

WELL LOCATION:  
 sec. 9 T-16 (N) R-16 (E)  
10 miles SW of Colo.  
 (distance) (direction) (nearest town)

Clay rock	16	158 1/2
Clay	159	159
hard clay	159	202

WELL PURPOSE: home  
 (home, irrigation, municipal, industrial)

sandy clay	202	300
small rock	300	307 1/2
sandy clay	307 1/2	307 1/2
small rock	307 1/2	315 1/2

WELL COMPLETION DATA:

(1) diameter (inches) 4"  
 (2) total depth (feet) 442'  
 (3) static water level (feet) 127.5 below top of ground.  
 (4) casing PVC 210'  
 (material) (depth)

sandy clay	315 1/2	318
small rock	318	
sandy clay	318	320
small rock	320	
sandy clay	320	325

(size) if telescope see back.

(5) screen 50' 2" PVC  
 (length) (depth to top) (size) (material)

sandy clay	320	325
gummy clay	325	345
small rock	345	
gummy clay	345	348
small rock	348	
clay	348	349
rocky	349	352
fine sandy streak	352	378

(6) pump \_\_\_\_\_ (HP) \_\_\_\_\_ (yield gpm)

elec.  
 (type power)

small rock	378	378
fine sandy	378	388
small rock	388	
fine sand	388	396
rock	396	397
fine sand	397	411 1/2
good sand	411 1/2	424
fine sand	424	442

(7) electric log no  
 (yes or no)

(organization running log)

(8) how well bottom plugged \_\_\_\_\_


DRILLERS REMARKS:  
Water level 127.5  
Pump set 190'

DEPT. OF NATURAL RESOURCES  
 BUREAU OF LAND & WATER RESOURCES

APR 27 1983  
**RECEIVED**

If well telescopes please sketch and show depths.

GROUND LEVEL

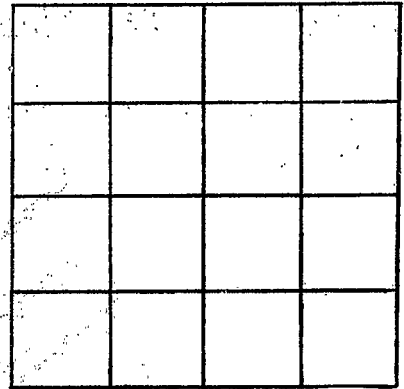

SECTION \_\_\_\_\_

Please indicate well location X.

ADDITIONAL INFORMATION

Multiple horizontal lines provided for recording additional information.

If more than one screen, show locations of each on sketch.

Handwritten notes on the left side of the sketch: "3'10 1/2' - 4\"", "198' - 2' - 86'", and "sand screen 50'".

