

Loundes
J 2003

MISSISSIPPI
 BOARD OF WATER COMMISSIONERS
 416 North State Street
 Jackson, Mississippi 39201

WATER WELL DRILLERS LOG

July 14, 1983 Mid South Drilling Company Loundes
 date well completed firm name county well located

LANDOWNER: Buddy Russell
Box 155
Artesia, MS 39736
 (mailing address)
 WELL LOCATION:
 sec. 29 T 18 N R. 16 E
1 miles S of Artesia
 (distance) (direction) (nearest town)

description of formations encountered	depth	
	from	to
clay	0	420
clay and sand	420	468
sand	468	480
clay and sand	480	668
sand	668	690
clay and sand	690	705

WELL PURPOSE:
 (home, irrigation, municipal, industrial)

WELL COMPLETION DATA:
 (1) diameter (inches) 4"
 (2) total depth (feet) 705'
 (3) static water level (feet) 130' below top of ground.
 (4) casing PVC 340'
 (material) (depth)
back if telescope see back.
 (size)
 (5) screen 100' 340'
 (length) (depth to top)
2" PVC
 (size) (material)
 (6) pump 3/4 10
 (HP) (yield gpm)
electric
 (type power)
 (7) electric log no
 (yes or no)
none
 (organization running log)
 (8) how well bottom plugged screen


DRILLERS REMARKS:

DEPT OF NATURAL RESOURCES
 BUREAU OF LAND & WATER RESOURCES


SEP 12 1983
 RECEIVED

If well telescopes please sketch and show depths.

GROUND LEVEL

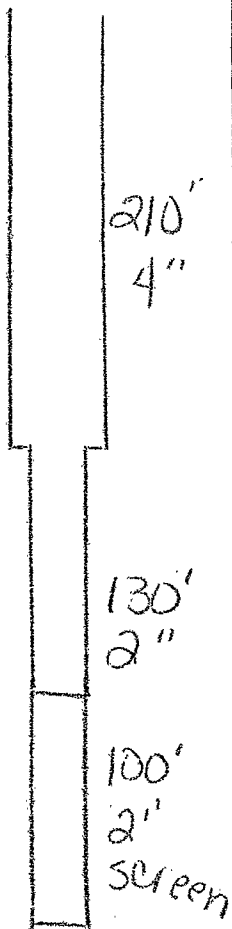

If more than one screen, show locations of each on sketch.

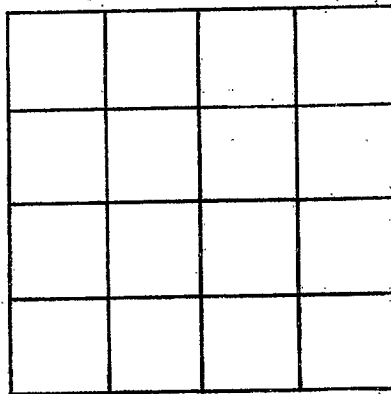

SECTION _____

Please indicate well location X.

ADDITIONAL INFORMATION

A series of horizontal lines provided for additional information, currently blank.