

Lowndes
8
2005

MISSISSIPPI
 BOARD OF WATER COMMISSIONERS
 416 North State Street
 Jackson, Mississippi 39201
 WATER WELL DRILLERS LOG

3/2 1999 Allsup Drilling, Inc. Lowndes
 date well completed firm name county well located

LANDOWNER: <u>West Flowers</u> <u>RR 1, Box 278 B</u>	description of formations encountered	from	to
<u>Columbus, MS 39701</u> (mailing address)	<u>CLAY</u>	<u>0'</u>	<u>12'</u>
WELL LOCATION: sec <u>25</u> T <u>18</u> N R <u>16</u> E	<u>LIME ROCK</u>	<u>12'</u>	<u>480'</u>
<u>4</u> miles <u>SE</u> of <u>ARTESIAN</u> (distance) (direction) (nearest town)	<u>1st SAND</u>	<u>480'</u>	<u>530'</u>
WELL PURPOSE: <u>Home</u> (home, irrigation, municipal, industrial)	<u>MUCK</u>	<u>530'</u>	<u>550'</u>
WELL COMPLETION DATA:	<u>2nd SAND</u>	<u>550'</u>	<u>600'</u>
(1) diameter (inches) <u>4"</u>			
(2) total depth (feet) <u>600'</u>			
(3) static water level (feet) <u>20'</u> below top of ground.			
(4) casing <u>PVC</u> (material) (depth) <u>4"x2"</u> if telescope see back. (size)			
(5) screen <u>80'</u> <u>520'</u> (length) (depth to top)			
(6) pump <u>1/2</u> <u>15'</u> (HP) (yield gpm)			
<u>Electric</u> (type power)			
(7) electric log <u>no</u> (yes or no)			
(8) how well bottom plugged <u>capped</u>			
DRILLERS REMARKS:			

DEPT. OF NATURAL RESOURCES
 BUREAU OF LAND & WATER RESOURCES

JUN 28 1994

RECEIVED

If well telescopes please sketch and show depths.


GROUND LEVEL

26' 4" CASING

468' LIME ROCK

200' 2" CASING

80' 2" SCREEN

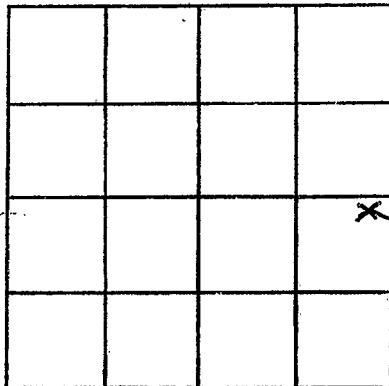

SECTION 25

Please indicate well location X.

ADDITIONAL INFORMATION

If more than one screen, show locations of each on sketch.