

MISSISSIPPI DEPARTMENT OF NATURAL RESOURCES

Bureau of Land and Water Resources

Southport Mall

P.O. Box 10631

Jackson, Mississippi 39209

WATER WELL DRILLERS LOG

LOWMEDES
J
2006

3-17-86 19
date well completed

Clardy Well Drilling Lowmedes
firm name county well located

LANDOWNER: James L. Steel
3115 Tamarack Trail
Columbus, Miss.
(mailing address)

WELL LOCATION:
sec. 4 T. 18 N. R. 16 E. S. W. ?
4 miles NE of Crawford
(distance) (direction) (nearest town)

WELL PURPOSE: Camp house
(home, irrigation, municipal, industrial)

- WELL COMPLETION DATA:
- (1) diameter (inches) 4"
 - (2) total depth (feet) 382
 - (3) static water level (feet) 99' below top of ground.
 - (4) casing PVC 372' (material) (depth) (size) If telescope see back.
 - (5) screen 10' (length) (depth to top) 4" (size) PVC (material)
 - (6) pump 3/4 (HP) 900 (yield gpm) gph (type power) elec
 - (7) electric log no (yes or no)
 - (8) how well bottom plugged

description of formations encountered	from	to
Brown Clay	0	11
lime rock	11	19
blue clay	19	39
rock	39	40
hard clay lime rock	40	60
red cyl lime rock	60	79
blue clay	79	127
sandy clay	127	132
rock	132	135
sandy clay	135	144
soft blue clay	144	158
rock	158	158.6
blue clay (soft)	158.6	179
hard blue clay	179	219
sm. rock		
blue clay	219	252
sm. rock		
blue clay	252	281
rock		
blue clay	281	284 1/2
rock 0.6"		
blue clay	284 1/2	300
sm. rock		
blue clay	300	314
sm. rock		
blue clay	314	324
sm. rock		
gummy clay	324	327
sm. rock		
gummy clay	327	341
sm. rock		
gummy clay	341	350
rock gummy clay	350	360
rock		
sandy clay	360	365
sand	365	372
rock		
sand	372	382


RECEIVED
APR 29 1986

DRILLERS REMARKS

Department of Natural Resources
Bureau of Land & Water

If well telescopes please sketch and show depths.

GROUND LEVEL

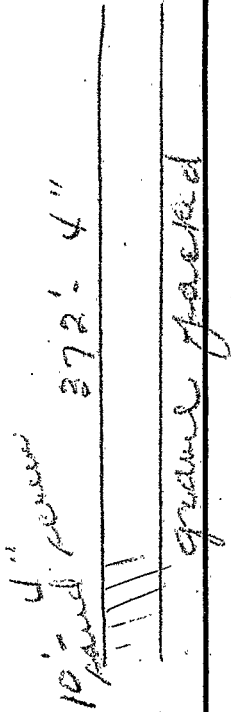

SECTION _____

Please indicate well location X.

ADDITIONAL INFORMATION

Multiple horizontal lines provided for entering additional information.

If more than one screen, show locations of each on sketch.