

# MISSISSIPPI DEPARTMENT OF NATURAL RESOURCES

Bureau of Land and Water Resources

COUNTY WELL LOCATED <b>Round Bay</b>	
WELL NUMBER <b>J</b>	CODED
DATE WELL COMPLETED <b>7/14/89</b>	

PERMIT NUMBER
NAME OF DRILLING FIRM <b>Clardy Well Drill Columbus, Mo. 39102</b>

P.O. Box 10631  
Jackson, Mississippi 39209  
**WATER WELL DRILLERS LOG**

NAME & MAILING ADDRESS OF LANDOWNER <b>Mr. John Scarborough 588 Bent Ave Columbus, Mo. 39101</b>			
WELL LOCATION: SEC	TOWNSHIP	RANGE	
<b>26</b>	<b>18 N</b>	<b>16 E</b>	<b>W</b>
DISTANCE	DIRECTION	NEAREST TOWN	
<b>6</b> Miles	<b>West</b>	<b>of Columbus</b>	
OTHER LANDMARK			
WELL PURPOSE: Home, Irrigation, Municipal, Industrial, Fish Pond, etc. <b>Home</b>			

PUMP DATA			
PUMP TYPE (Circle One): <input checked="" type="radio"/> Submersible, <input type="radio"/> Turbine, <input type="radio"/> Jet <input type="radio"/> Flowing Well, Other (Describe) _____			
POWER TYPE (Circle One): <input checked="" type="radio"/> Electric, <input type="radio"/> Tractor, <input type="radio"/> Diesel, <input type="radio"/> Gasoline, <input type="radio"/> Butane, Other (Describe) _____			
Pump Capacity (GPM)	No. of Stages	Setting Depth	
<b>900</b>	<b>12</b>	<b>180</b> FT.	
PUMP TEST			
Well yielded <b>900</b> GPM with a drawdown of _____ ft. after _____ hours of pumping			

WELL DATA		
Well Depth <b>340'</b>	Casing Diameter (In.) <b>4"</b>	Casing Length (Ft.) <b>202</b>
Type of Casing <b>PVC</b>	Hole Depth	Depth to Static Water Level <b>130'</b>
TYPE OF COMPLETION: (Circle One or More): <input type="radio"/> Gravel Packed, <input type="radio"/> Underreamed, <input type="radio"/> Telescoped, <input type="radio"/> Natural Development, <input type="radio"/> Open Hole, <input type="radio"/> Other		
Top of Lap Pipe or Reduction in Casing		
FEET IF TELESCOPED OR MORE THAN ONE SCREEN: USE BACK PAGE		

LOG DATA	
TYPE OF LOG RUN (Circle One): <input type="radio"/> No Log Run, <input type="radio"/> Electric, <input type="radio"/> Gamma Ray, <input type="radio"/> Density, <input type="radio"/> Sonic, <input type="radio"/> Neutron, Other (Describe) _____	
Name of Organization Running Log	


SCREEN DATA		
Diameter - Inches <b>2"</b>	Length - Feet <b>40'</b>	Slot Size - Inches <b>.013</b>
Screen Type <b>PVC</b>		Depth to Bottom - Feet

<b>RECEIVED</b> GEOLOGIC DATA (Office Use Only)			
Surface Elev.	Geologic Unit	Unit Thickness	Depth to Top
Subs. SWL	Date <b>AUG 16 1989</b>	Analysis	Aquifer Test
Driller's Remarks			
<b>Department of Natural Resources Bureau of Land &amp; Water Resources</b>			

DESCRIPTION OF FORMATIONS ENCOUNTERED	FROM	TO	FORMATIONS (Continued)	FROM	TO
Brown clay	0	6	Soft clay	198	208
Blue clay	6	66	sm. rock	208	
Rock	66	67	Soft clay	208	221
Clay	67	90	Clay	221	237 1/2
Rocky	90	92	sm. rock	237 1/2	
Clay	92	181	Clay	237 1/2	242
Fine clay	181	193	sm. rock	242	
Clay	193	196	Rocky sandy clay	242	252
Small rock	196		Fine sand	252	262
Clay	196	198	sandy clay	262	293
sm. rock	198				

IF MORE SPACE IS NEEDED, USE BACK

If well telescopes please sketch and show depths.

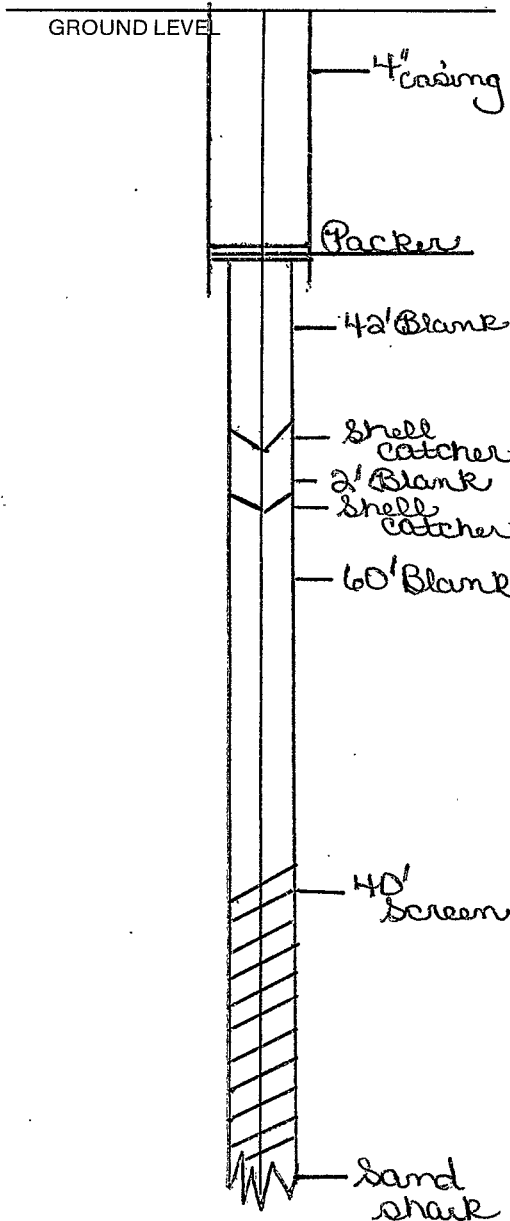


SECTION \_\_\_\_\_

Please indicate well location X.

ADDITIONAL INFORMATION

Rock	293-294
Fine sand	294-307
Hard rock	307-308
Sand	308-332
Fine sand	332-340

If more than one screen, show location of each on sketch.