

LOWNDEN

K
6-9-80

**MISSISSIPPI
BOARD OF WATER COMMISSIONERS**
416 North State Street
Jackson, Mississippi 39201

WATER WELL DRILLERS LOG

Juen 9, 1980 19 Mid South Drilling Co. Lowndes
 date well completed firm name county well located

LANDOWNER: Roy Griffin

description of formations encountered	from	to
clay	0	135
clay and sand	135	300

Columbus, MS 39701
(mailing address)

WELL LOCATION:

sec. 34 T 19 N R 17 E
1/2 miles SW of Col.
 (distance) (direction) (nearest town)

WELL PURPOSE: home
(home, irrigation, municipal, industrial)

WELL COMPLETION DATA:

- (1) diameter (inches) 4
- (2) total depth (feet) 300
- (3) static water level (feet) 100 below above top of ground.
- (4) casing PVC, 150
 (material), (depth),
4"
 (size) if telescope see back.
- (5) screen n/a
 (length), (depth to top)
n/a
 (size), (material)
- (6) pump n/a
 (HP), (yield gpm)
n/a
 (type power)
- (7) electric log no
 (yes or no)
no
 (organization running log)
- (8) how well bottom plugged open

DEPT. OF NATURAL RESOURCES
BUREAU OF LAND & WATER RESOURCES


JUL 14 1980

RECEIVED

DRILLERS REMARKS:

If well telescopes please sketch and show depths.

GROUND LEVEL

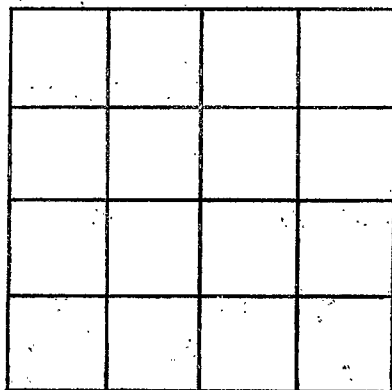

SECTION _____

Please indicate well location X.

ADDITIONAL INFORMATION

If more than one screen,
show locations of each on sketch.