

**LOWNDES**  
**K 14**  
**6-29-72**

MISSISSIPPI  
 BOARD OF WATER COMMISSIONERS  
 416 North State Street  
 Jackson, Mississippi 39201

**CODED**

**WATER WELL DRILLERS LOG**

6/29/72 19 Clardy Well & Pump Service Lowndes  
 date well completed firm name county well located

LANDOWNER: Joe Harris  
Highway 45 South  
Columbus, Miss.  
 (mailing address)

WELL LOCATION:  
 sec. 22 T. 19 N. R. 17 E  
S W  
6 miles South of Columbus  
 (distance) (direction) (nearest town)

WELL PURPOSE: home  
 (home, irrigation, municipal, industrial)

WELL COMPLETION DATA:

- (1) diameter (inches) 4"
- (2) total depth (feet) 275'
- (3) static water level (feet) 40' below above top of ground.
- (4) casing 4" steel, 105'  
 (material) (depth)  
 (size) if telescope see back.
- (5) screen \_\_\_\_\_  
 (length) (depth to top)  
 (size) (material)
- (6) pump 1/2 Sub 750  
 (HP) (yield gpm)  
 (type power)
- (7) electric log \_\_\_\_\_  
 (yes or no)  
 (organization running log)
- (8) how well bottom plugged Open

description of formations encountered	from	to
<u>brown or orange clay</u>	<u>0</u>	<u>10</u>
<u>lime or grey clay</u>	<u>10</u>	<u>50</u>
<u>blue clay</u>	<u>50</u>	<u>120</u>
<u>sandy blue clay</u>	<u>120</u>	<u>130</u>
<u>rocks</u>	<u>130</u>	<u>131</u>
<u>sandy blue clay</u>	<u>131</u>	<u>140</u>
<u>rocks</u>	<u>140</u>	<u>141</u>
<u>sandy blue clay</u>	<u>141</u>	<u>150</u>
<u>rocks</u>	<u>150</u>	<u>151</u>
<u>blue clay</u>	<u>151</u>	<u>165</u>
<u>rocks</u>	<u>165</u>	<u>167</u>
<u>sandy clay (hard)</u>	<u>167</u>	<u>170</u>
<u>sandy clay</u>	<u>170</u>	<u>190</u>
<u>rocks</u>	<u>190</u>	<u>191</u>
<u>sandy clay</u>	<u>191</u>	<u>200</u>
<u>rocks</u>	<u>200</u>	<u>202</u>
<u>sandy clay</u>	<u>202</u>	<u>225</u>
<u>rock</u>	<u>225</u>	<u>226</u>
<u>sandy clay</u>	<u>226</u>	<u>230</u>
<u>rocks</u>	<u>230</u>	<u>231</u>
<u>fine sand</u>	<u>231</u>	<u>240</u>
<u>course sand + rocks</u>	<u>240</u>	<u>275</u>

**CODED**


JUL 10 1972

DRILLERS REMARKS:


If well telescopes please sketch and show depths.

*Handwritten notes, possibly "100 ft" and "100 ft"*

GROUND LEVEL

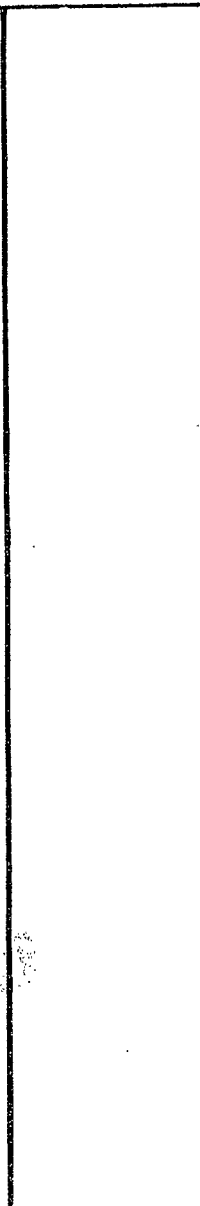

If more than one screen, show locations of each on sketch.

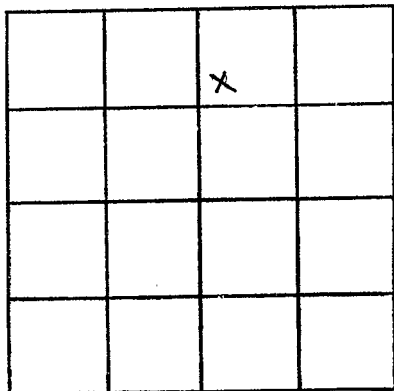

SECTION \_\_\_\_\_

Please indicate well location X.

ADDITIONAL INFORMATION

Lined area for additional information.