

Lowndes  
K-15  
8/5/71

MISSISSIPPI  
BOARD OF WATER COMMISSIONERS  
416 North State Street  
Jackson, Mississippi 39201

WATER WELL DRILLERS LOG

**CODED**

8/5 1971 date well completed  
JLHSD Drilling Co firm name  
LOWNDES county well located

LANDOWNER: 2105<sup>th</sup> AV S. 3285716  
MR JOE SAMS, SR  
Columbus, Miss.  
(mailing address)

description of formations encountered	from	to
CLAY	0	8
BLUE ROCK	8	131
SAND	131	212
Mud. K.	212	229
SAND	229	425

WELL LOCATION:  
sec. 9 T. 18 N R. 17 E  
3 1/2 miles SW of Columbus  
(distance) (direction) (nearest town)

WELL PURPOSE: HOME  
(home, irrigation, municipal, industrial)

- WELL COMPLETION DATA:
- (1) diameter (inches) 4" x 2"
  - (2) total depth (feet) 425
  - (3) static water level (feet) 60' below top of ground.
  - (4) casing Plastic, 28' (material) (depth)  
4" (size) if telescope see back.
  - (5) screen 80' 345' (length) (depth to top)  
2" PLASTIC (size) (material)
  - (6) pump 1/2 Sub 10 (HP) (yield gpm)  
ELECTRIC (type power)
  - (7) electric log No (yes or no)
  - (organization running log)
  - (8) how well bottom plugged CAP



**CODED**

SEP 10 1971

DRILLERS REMARKS:

MISS. BD. OF  
WATER COM.

If well telescopes please sketch and show depths.

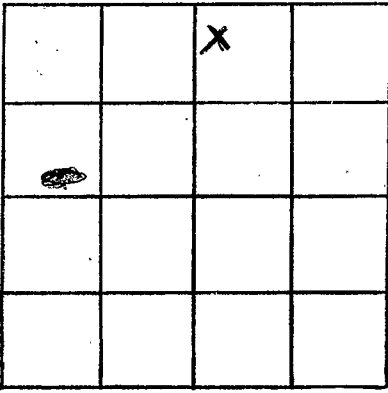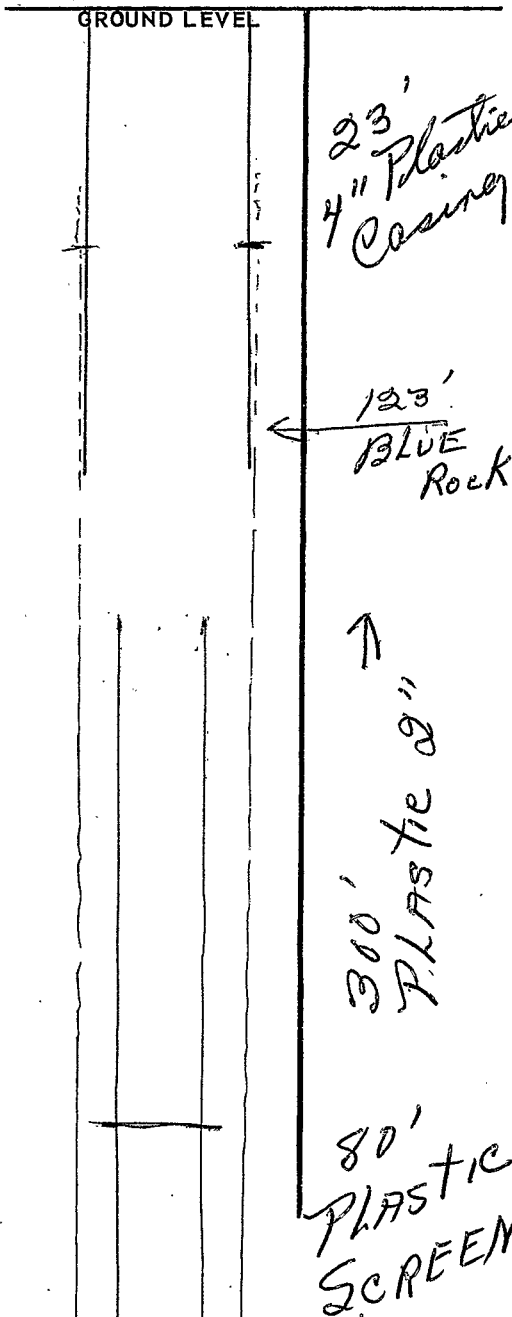

SECTION 9

Please indicate well location X.

ADDITIONAL INFORMATION

Lined area for additional information.

If more than one screen, show locations of each on sketch.