

Lowndes

K16

2-4-72

MISSISSIPPI  
 BOARD OF WATER COMMISSIONERS  
 416 North State Street  
 Jackson, Mississippi 39201

WATER WELL DRILLERS LOG

2-4

1972 W.J. REEVES 2 SON

LOWNDES

date well completed

firm name

county well located

LANDOWNER: W. J. ADAIR

RT 1

COLUMBUS

(mailing address)

WELL LOCATION:

sec. 2 T. 18 N R. 17 E  
 (distance) miles (direction) of (nearest town)

4 miles SW of COLUMBUS

WELL PURPOSE: HOME  
 (home, irrigation, municipal, industrial)

WELL COMPLETION DATA:

(1) diameter (inches) 4

(2) total depth (feet) 400

(3) static water level (feet) 75 below above top of ground.

(4) casing STEEL 35  
(material) (depth)

4 If telescope see back.  
(size)

(5) screen NONE  
(length) (depth to top)

(size) (material)

(6) pump 1 12  
(HP) (yield gpm)

ELECT  
(type power)

(7) electric log NO  
(yes or no)

(organization running log)

(8) how well bottom plugged OPEN

description of formations encountered

from

to

CLAY

0 16

BLUE CLAY

16 125

BLUE SANDV

125 139

BLUE CLAY

139 275

BLUE SANDV

275 297

BLUE CLAY

297 318

BLUE SANDV

318 362

BLUE CLAY

362 400


14  
22  
44  
~~100~~  
10

DRILLERS REMARKS:

WARRANT 27 1073

If well telescopes please sketch and show depths.

GROUND LEVEL

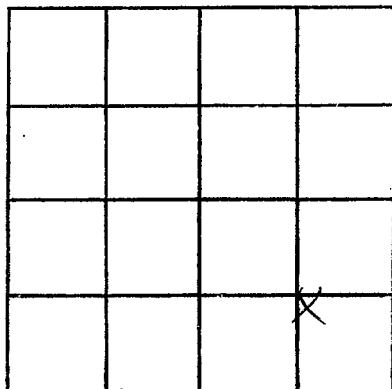

SECTION 2

Please indicate well location X.

ADDITIONAL INFORMATION

If more than one screen, show locations of each on sketch.