

LOWMEES

MISSISSIPPI BOARD OF WATER COMMISSIONERS

K17

10-63

WATER WELL DRILLERS LOG

CODED

Date: Oct 19 1963, Driller: W B Clardy County Lowndes

15860, 61 15706

(Name)

(1) Owner of Land:	Description & Color of Materials Sand, Clay, Red Clay, Shell, etc.	Thick- ness Feet	Depth Feet
Joe Sams Jr. (Name) BENT OAK RD 3285003 (Address)	17'-200' Blue Clay		
SE SE 1/4 SW 1/4, Sec. 4 T18R17E 8 miles SW of Calo. (distance) (direction) (Nearest Town)	200'-250' Sand		
(3) Topography: (Hilly) (Flat) (Level)			
(4) Purpose of Well: (Domestic Irrigation Municipal, Industrial, Other)			

Information upon completion of well:


- (1) Diameter 4 inches.
- (2) Total Depth 255 feet.
- (3) Water Level \_\_\_\_\_ feet below top of ground.
- (4) Cased to 22', Size 4"
- (5) Screen: Size \_\_\_\_\_, Length \_\_\_\_\_.
- (6) Were any formations sealed against pollution?  
\_\_\_\_\_ yes, \_\_\_\_\_ no.

If YES depth of formation \_\_\_\_\_

Why \_\_\_\_\_

Drillers Remarks: \_\_\_\_\_

CODED

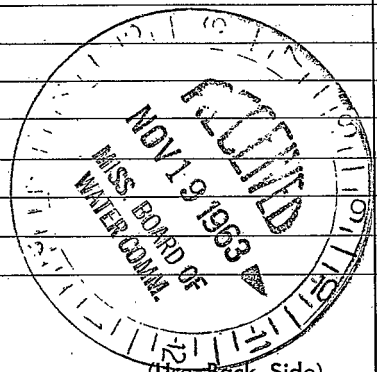

(Use Back Side)

Well No.

