

Lowndes

K18

1-29-72

MISSISSIPPI
 BOARD OF WATER COMMISSIONERS
 416 North State Street
 Jackson, Mississippi 39201

WATER WELL DRILLERS LOG

1-29 1972
date well completed

W. J. REEVES & SON
firm name

LOWNDES
county well located

LANDOWNER: BIRNEY IMES JR.

CHICKASAW DRIVE

COLUMBUS

(mailing address)

WELL LOCATION:

sec. 30 T 18 N R 17 E
 10 miles SW of COLUMBUS
 (distance) (direction) (nearest town)

WELL PURPOSE: HOME
 (home, irrigation, municipal, industrial)

WELL COMPLETION DATA:

- (1) diameter (inches) 4 X 2
- (2) total depth (feet) 632
- (3) static water level (feet) 90 below top of ground
- (4) casing STEEL 632 (material) (depth)
 4 X 2 (size) if telescope-see back.
- (5) screen 90 443 (length) (depth to top)
 2 STEEL (size) (material)
- (6) pump 1/2 25 (HP) (yield gpm)
 ELECT (type power)
- (7) electric log X (yes or no)
 (organization running log)
- (8) how well bottom plugged VALVE

description of formations encountered

from to

CLAY	0	16
BLUE CLAY	16	305
BLUE SAND	305	325
BLUE CLAY	335	345
BLUE SANDY CLAY	345	358
BLUE CLAY	358	402
BLUE SANDY CLAY	402	430
BLUE CLAY	430	443
BLUE SD + CLAY STREAKS	443	460
BLUE SAND	460	473
BLUE CLAY	473	503
BLUE SD + CLAY STREAKS	503	513
BLUE CLAY	513	553
BLUE SD + CLAY	553	563
BLUE CLAY	563	566
GRAY SD + CLAY STRS	566	630
BLUE CLAY	630	632


DRILLERS REMARKS:

SORRY FORMATION

MADE BY
W. J. REEVES

If well telescopes please sketch and show depths.

GROUND LEVEL

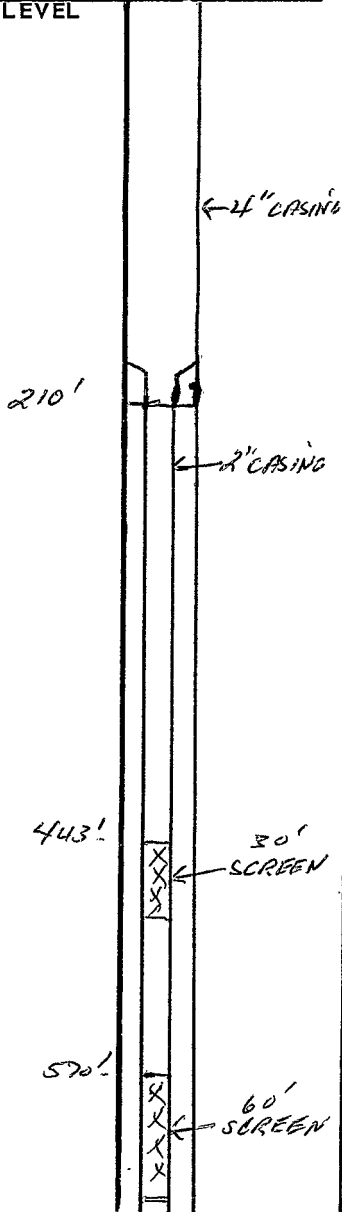

			X

SECTION 30

Please indicate well location X.

ADDITIONAL INFORMATION

If more than one screen, show locations of each on sketch.