

MISSISSIPPI
BOARD OF WATER COMMISSIONERS
416 North State Street
Jackson, Mississippi 39201

CODED

WATER WELL DRILLERS LOG

LOWNDES
K21
1-23-73

1-23-73 19 ALLSUP DRILLING CO. Lowndes
date well completed firm name county well located

LANDOWNER: Frank Schaffer
Columbus, Miss

description of formations encountered	from	to
<u>Top Soil</u>	<u>0</u>	<u>37</u>
<u>Blue R.P.K.</u>	<u>37</u>	<u>98</u>
<u>Sand</u>	<u>98</u>	<u>140</u>
<u>Muck</u>	<u>140</u>	<u>184</u>
<u>Sand</u>	<u>184</u>	<u>323</u>

(mailing address)

WELL LOCATION:
sec. 10 T. 18 N. R. 17 E.
3 miles SW of Columbus
(distance) (direction) (nearest town)

WELL PURPOSE:
(home, irrigation, municipal, industrial)

WELL COMPLETION DATA:

- (1) diameter (inches) 4 X 2
- (2) total depth (feet) 323
- (3) static water level (feet) 95 below above top of ground.
- (4) casing Plastic, 40'
(material) (depth)
4" if telescope see back.
(size)
- (5) screen 84', 2.39'
(length) (depth to top)
2", Plastic
(size) (material)
- (6) pump 1 10
(HP) (yield gpm)
elect.
(type power)
- (7) electric log _____
(yes or no)


(organization running log)
- (8) how well bottom plugged cap

CODED

DRILLERS REMARKS:

If well telescopes please sketch and show depths.

GROUND LEVEL

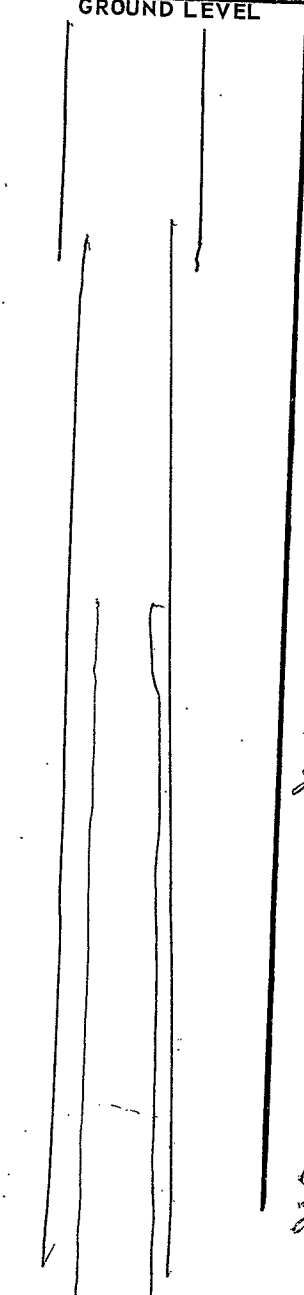

40'
4" casing

58'
Blue Rock

136'
2" casing

84'
2" Screen

			8X

SECTION 10

Please indicate well location X.

ADDITIONAL INFORMATION

If more than one screen, show locations of each on sketch.