

LOWNDES
K 23
10-26-73

MISSISSIPPI
BOARD OF WATER COMMISSIONERS
416 North State Street
Jackson, Mississippi 39201

WATER WELL DRILLERS LOG

CODED

10/26
date well completed

1973

Lawrence E. Ebb
firm name

Lawrence
county well located

LANDOWNER: *Jessie Gant*

description of formations encountered

from to

*Stop Soil
Chalk
Sand*

*0 12
12 28
280 460*

Columbus, Miss
(mailing address)

WELL LOCATION:

sec. *16* T. *18* N. R. *17* E
S

4 miles *S.W.* of *Columbus*
(distance) (direction) (nearest town)

WELL PURPOSE: *Home*
(home, irrigation, municipal, industrial)

WELL COMPLETION DATA:

- (1) diameter (inches) *5"*
(2) total depth (feet) *400*
(3) static water level (feet) _____ below
top of ground. above
(4) casing *2 1/2" steel casing*
(material) (depth)

_____ if telescope see back.
(size)

- (5) screen *0* _____
(length) (depth to top)

_____ (size) _____ (material)

- (6) pump *1/2* _____ *8*
(HP) (yield gpm)

Electric
(type power)

- (7) electric log _____
(yes or no)

_____ (organization running log)

- (8) how well bottom plugged _____

DRILLERS REMARKS:


CODED

MISS. STATE
WATER

MISS. STATE
WATER

If well telescopes please sketch and show depths.

GROUND LEVEL

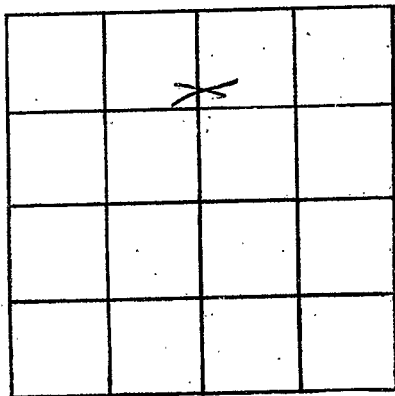

SECTION _____

Please indicate well location X.

ADDITIONAL INFORMATION

If more than one screen, show locations of each on sketch.