

LOWNDES
K24
11-24-73

MISSISSIPPI
 BOARD OF WATER COMMISSIONERS
 416 North State Street
 Jackson, Mississippi 39201

WATER WELL DRILLERS LOG

11/24/73 date well completed 1973 *Norman Echols* firm name *Lowndes* county well located

LANDOWNER: *John G. Atkinson*
+ Albert Atkinson
Columbus miss
 (mailing address)

description of formations encountered	from	to
<i>Red clay</i>	<i>@</i>	<i>10</i>
<i>clay</i>	<i>10</i>	<i>280</i>
<i>Sand</i>	<i>280</i>	<i>400</i>

WELL LOCATION:
 sec. 10 T. 18 N R. 17 E
 S W
3 1/2 miles S.W. of Columbus
 (distance) (direction) (nearest town)

WELL PURPOSE: None
 (home, irrigation, municipal, industrial)

- WELL COMPLETION DATA:
- (1) diameter (inches) 5"
 - (2) total depth (feet) 400
 - (3) static water level (feet) _____ below above top of ground.
 - (4) casing 2 1/2" Steel casing
 (material) (depth)
 _____ if telescope see back.
 (size)
 - (5) screen Ø
 (length) (depth to top)

 (size) (material)
 - (6) pump _____
 (HP) (yield gpm)

 (type power)
 - (7) electric log _____
 (yes or no)

 (organization running log)
 - (8) how well bottom plugged _____


CODED

DRILLERS REMARKS:
Put in pump in

MADE IN U.S.A.
 WATSON

If well telescopes please sketch and show depths.

GROUND LEVEL

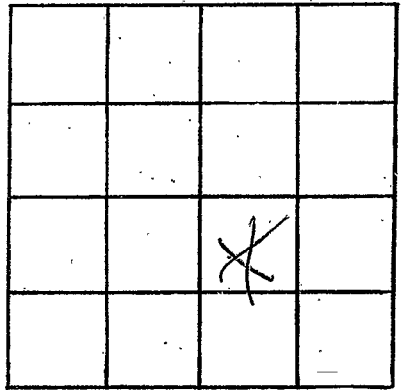

SECTION _____

Please indicate well location X.

ADDITIONAL INFORMATION

If more than one screen, show locations of each on sketch.