

LOWNOES

K 25

8-16-73

MISSISSIPPI BOARD OF WATER COMMISSIONERS
416 North State Street
Jackson, Mississippi 39201

CODED

WATER WELL DRILLERS LOG

8/16 date well completed

1973

Norman Chalmers firm name

Lowndes county well located

LANDOWNER: Dick Kyle
115 South
Columbus, Miss
(mailing address)

description of formations encountered	from	to
Top Soil	0	14
Clay	14	260
Sand	260	100

WELL LOCATION:
sec. 16 T. 18 N R. 17 E
S W
6 miles S W of Columbus
(distance) (direction) (nearest town)

WELL PURPOSE:
(home, irrigation, municipal, industrial)

- WELL COMPLETION DATA:
- (1) diameter (inches) 5"
 - (2) total depth (feet) 100
 - (3) static water level (feet) _____ below/above top of ground.
 - (4) casing 21' (material) 5" casing (depth)
_____ if telescope see back. (size)
 - (5) screen 0 (length) _____ (depth to top)
_____ (size) _____ (material)
 - (6) pump 1/2 (HP) 7 (yield gpm)
Electric (type power)
 - (7) electric log _____ (yes or no)
_____ (organization running log)
 - (8) how well bottom plugged _____


CODED

DRILLERS REMARKS:

JAN 2 1974
MISSISSIPPI BOARD OF WATER COMMISSIONERS

If well telescopes please sketch and show depths.

GROUND LEVEL

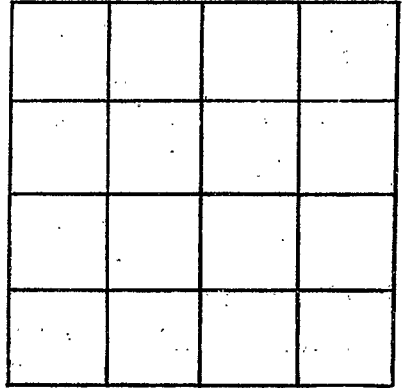

SECTION _____

Please indicate well location X.

ADDITIONAL INFORMATION

If more than one screen, show locations of each on sketch.