

LOWNDES

K26

4-2-74

MISSISSIPPI BOARD OF WATER COMMISSIONERS  
416 North State Street  
Jackson, Mississippi 39201

CODED

WATER WELL DRILLERS LOG


4-2  
date well completed

1974 W. J. REEVES & SON  
firm name

LOWNDES  
county well located

| LANDOWNER: <u>ROMLEY EDGE</u><br><u>RT. 1</u>  | description of formations encountered | from       | to         |
|--|---------------------------------------|------------|------------|
| <u>COLUMBUS</u><br>(mailing address)   | <u>CLAY</u>                           | <u>0</u>   | <u>23</u>  |
| WELL LOCATION:<br>sec. <u>2</u> T. <u>18</u> N R. <u>17</u> E<br>SW SE NW            | <u>BLUE CLAY</u>                      | <u>23</u>  | <u>110</u> |
| <u>5</u> miles <u>SW</u> of <u>COLUMBUS</u><br>(distance) (direction) (nearest town) | <u>SANDY BLUE CLAY</u>                | <u>110</u> | <u>225</u> |
| WELL PURPOSE: <u>HOME</u><br>(home, irrigation, municipal, industrial)               | <u>BLUE CLAY</u>                      | <u>225</u> | <u>270</u> |
| WELL COMPLETION DATA:<br>(1) diameter (inches) <u>4</u>                              | <u>1" SAND</u>                        | <u>270</u> | <u>282</u> |
| (2) total depth (feet) <u>380</u>  | <u>1" CLAY</u>                        | <u>282</u> | <u>310</u> |
| (3) static water level (feet) <u>60</u> below above top of ground.                   | <u>BLUE SAND + CLAY</u>               | <u>310</u> | <u>380</u> |
| (4) casing <u>PVC</u> , <u>41</u> ,<br>(material) (depth)                            | <u>STREAKS</u>                        |            |            |
| <u>4</u> if telescope see back.<br>(size)  |                                       |            |            |
| (5) screen _____<br>(length) (depth to top)  |                                       |            |            |
| (6) pump <u>1/2</u> <u>7</u><br>(HP) (yield gpm)                                     |                                       |            |            |
| <u>ELECT</u><br>(type power)   |                                       |            |            |
| (7) electric log <u>No</u><br>(yes or no)  |                                       |            |            |
| (8) how well bottom plugged <u>OPEN</u>  |                                       |            |            |
| DRILLERS REMARKS:  |                                       |            |            |

CODED

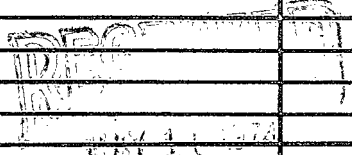

MISSISSIPPI BOARD OF WATER COMMISSIONERS

If well telescopes please sketch and show depths.

GROUND LEVEL

|  |  |  |   |
|--|--|--|---|
|  |  |  |   |
|  |  |  | X |
|  |  |  |   |
|  |  |  |   |

SECTION 2

Please indicate well location X.

ADDITIONAL INFORMATION

If more than one screen, show locations of each on sketch.