

LOWNDES
K 28
11-27-74

MISSISSIPPI
BOARD OF WATER COMMISSIONERS
416 North State Street
Jackson, Mississippi 39201

CODED

WATER WELL DRILLERS LOG

11-27 1974 W. J. REEVES, JR. LOWNDES
date well completed firm name county well located

LANDOWNER: CAROL SUE ANDREWS
RT. 1
COLUMBUS
(mailing address)

description of formations encountered	from	to
CLAY	0	22
BUDE CLAY	22	118
" SAND	118	129
" CLAY	129	210
BUDE SAND + CLAY STREAKS	210	280

WELL LOCATION:
sec. 11 T 18 N R 17 E
S W SW of COLUMBUS
(distance) (direction) (nearest town)
6 miles

WELL PURPOSE: 140 A F
(home, irrigation, municipal, industrial)


- WELL COMPLETION DATA:
- (1) diameter (inches) 4
 - (2) total depth (feet) 280
 - (3) static water level (feet) 48 below above top of ground.
 - (4) casing PVC 40 (material) (depth)
4 (size) If telescope see back.
 - (5) screen NONE (length) (depth to top)
(size) (material)
 - (6) pump 1/2 8 (HP) (yield gpm)
ELECT (type power)
 - (7) electric log NO (yes or no)
 - (8) how well bottom plugged OPEN

DRILLERS REMARKS:

RECEIVED
MAR 17 1975
MISS. Bd. of Water Comm.

If well telescopes please sketch and show depths.

GROUND LEVEL

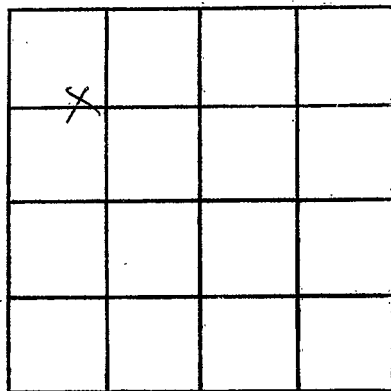

SECTION 11

Please indicate well location X.

ADDITIONAL INFORMATION

If more than one screen,
show locations of each on sketch.