

Lowndes
K29
6-2-76
Flg #66
6-2

MISSISSIPPI
 BOARD OF WATER COMMISSIONERS
 416 North State Street
 Jackson, Mississippi 39201

CODED

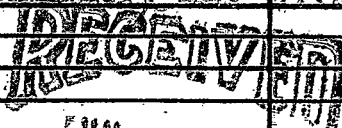
WATER WELL DRILLERS LOG

date well completed

firm name

county well located

1976 Logan Central Company Lowndes

| LANDOWNER: | description of formations encountered | from | to |
|---|--|------------|------------|
| <u>Car-Rent</u> | | | |
| <u>Columbus, Miss</u> | <u>Fine clay</u> | <u>0</u> | <u>4</u> |
| (mailing address) | <u>Loam</u> | <u>4</u> | <u>28</u> |
| WELL LOCATION: | <u>Hard clay</u> | <u>28</u> | <u>159</u> |
| sec. <u>3</u> T. <u>19</u> N. R. <u>17</u> E. | <u>Clay and Sand Strata</u> | <u>159</u> | <u>200</u> |
| (distance) miles of (direction) (nearest town) | <u>Hard clay</u> | <u>200</u> | <u>350</u> |
| WELL PURPOSE: <u>Industrial</u> | <u>Sandy Shales</u> | <u>350</u> | <u>404</u> |
| (home, irrigation, municipal, industrial) | <u>Hard clay and Sand Strata</u> | <u>404</u> | <u>482</u> |
| WELL COMPLETION DATA: | <u>Sand</u> | <u>482</u> | <u>497</u> |
| (1) diameter (inches) <u>12"</u> | <u>Clay</u> | <u>497</u> | <u>530</u> |
| (2) total depth (feet) <u>634'</u> | <u>Sandy Shale</u> | <u>530</u> | <u>579</u> |
| (3) static water level (feet) <u>84'</u> below top of ground. | <u>Sand</u> | <u>579</u> | <u>630</u> |
| (4) casing <u>Steel</u> <u>577'</u> (material) (depth) | <u>Hard clay</u> | <u>630</u> | <u>704</u> |
| <u>12"</u> if telescope see back. (size) <u>30' x 8"</u> | <u>Sand</u> <u>PAVED</u> | <u>704</u> | <u>723</u> |
| (5) screen <u>50'</u> <u>577'</u> (length) (depth to top) | <u>Clay</u> | <u>723</u> | <u>732</u> |
| <u>8"</u> (size) <u>S.S.</u> (material) | <u>Sandy Strata of Clay</u> | <u>732</u> | <u>774</u> |
| (6) pump <u>60</u> <u>500</u> (HP) (yield gpm) | <u>Hard clay</u> | <u>774</u> | <u>822</u> |
| <u>Electric</u> (type power) | <u>Sand</u> | <u>822</u> | <u>826</u> |
| (7) electric log <u>yes</u> (yes or no) | <u>Hard clay</u> | <u>826</u> | <u>866</u> |
| <u>Miss. Geol. Survey</u> (organization running log) | <u>Sand</u> | <u>866</u> | <u>875</u> |
| (8) how well bottom plugged: <u>Valve</u> | <u>Clay</u> | <u>875</u> | <u>905</u> |
| DRILLERS REMARKS: | <p> <u>Shows 11595 elec</u> <u>11595 in map</u> <u>71</u>  <u>JUL 27 1976</u> MISS. BD. OF WATER COMMISSIONERS </p> | | |

(4)

If well telescopes please sketch and show depths.

GROUND LEVEL

| | | | |
|--|--|--|--|
| | | | |
| | | | |
| | | | |
| | | | |

SECTION _____

Please indicate well location X.

ADDITIONAL INFORMATION

If more than one screen, show locations of each on sketch.