

Elog #83

LOWNDES  
K32  
6-19-81  
~~6-19-81~~


MISSISSIPPI  
BOARD OF WATER COMMISSIONERS  
416 North State Street  
Jackson, Mississippi 39201

CODED

WATER WELL DRILLERS LOG

19 June 1981 Herndon Well & Supply, Inc. Lowndes  
date well completed firm name county well located

LANDOWNER: Golden Triangle	description of formations encountered		from	to
Industrial Park Well #1	Gumbo & Gray Sand		0	30
Lowndes County, MS	Gray Gumbo		30	270
(mailing address)	Streaked Gumbo & Sand		270	300
WELL LOCATION:	Sand		200	340
sec. 6 T18 N R 17 E	Streaked Sand & Shale		340	360
6 miles West of Columbus	Gumbo		360	390
(distance) (direction) (nearest town)	Gumbo & Sand		390	420
WELL PURPOSE: Industrial	Gumbo		420	690
(home, irrigation, municipal, industrial)	Streaked Gumbo & Sand		690	720
WELL COMPLETION DATA:	Gumbo		720	750
(1) diameter (inches) 16"	Pink & Gray Gumbo		750	810
(2) total depth (feet) 1360'	Gumbo		810	840
(3) static water level (feet) 90 below top of ground.	Streaked Gumbo & Sand		840	870
(4) casing Steel 1260	Gumbo		870	960
(material) (depth)	Sand 20' & Gumbo 10'		960	990
16 x 10 if telescope see back.	Gumbo		990	1080
(size)	Sand & Streaked Gumbo		1080	1110
(5) screen 80' 1260'	Pink Gumbo 20' & Gumbo 10'		1110	1140
(length) (depth to top)	Streaked Gumbo & Sand		1140	1200
10" SS Ribbed	Sand		1200	1230
(size) (material)	Sand 10', Gumbo 10', Sand 10'		1230	1260
(6) pump 125 945	Sand		1260	1290
(HP) (yield gpm)	Streaked Sand & Gumbo		1290	1320
Electric	Sand		1320	1387
(type power)				
(7) electric log yes				
(yes or no)				
MS Geo. Survey				
(organization running log)				
(8) how well bottom plugged BW Valve				
DRILLERS REMARKS:				

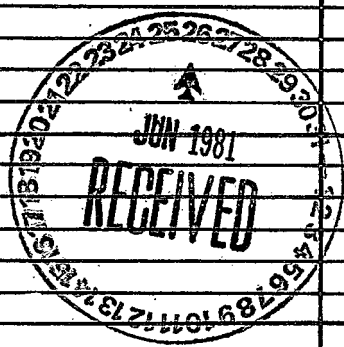

(X)

If well telescopes please sketch and show depths.

GROUND LEVEL

1260' 18" casing

Top of Lap  
1174'

Top of  
Screen 1260'

60' of 10" Screen

20' 10" Blank

20' 10" Screen

B.W. Valve

1360'


1174

1260

1261

1360

1362

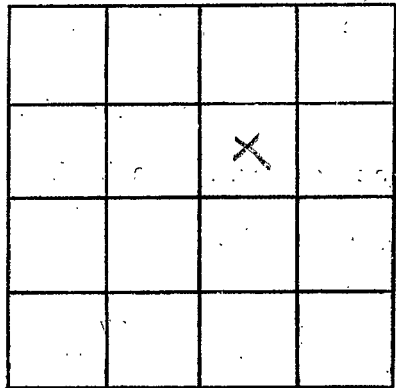

SECTION 6

Please indicate well location X.

ADDITIONAL INFORMATION

If more than one screen, show locations of each on sketch.