

LOWNDES
K37
6-19-81
Elog #90

MISSISSIPPI
 BOARD OF WATER COMMISSIONERS
 416 North State Street
 Jackson, Mississippi 39201

CODED

WATER WELL DRILLERS LOG

19 June 1981 Herndon Well & Supply, Inc. Lowndes
 date well completed firm name county well located


LANDOWNER: Golden Triangle
Industrial Park Well #2
Lowndes County, MS
 (mailing address)

WELL LOCATION:
 sec 6 T8 N R 17 E
 6 miles West of Columbus
 (distance) (direction) (nearest town)

WELL PURPOSE: Industrial
 (home, irrigation, municipal, industrial)

WELL COMPLETION DATA:
 (1) diameter (inches) 12"
 (2) total depth (feet) 1312'
 (3) static water level (feet) 85 ^{below} ~~xxxx~~
 top of ground.
 (4) casing Steel, 1220
 (material) (depth)
12 x 8" if telescope see back.
 (size)
 (5) screen 80', 1220
 (length) (depth to top)
8", SS Ribbed
 (size) (material)
 (6) pump 100 1084
 (HP) (yield gpm)
Elec.
 (type power)
 (7) electric log yes
 (yes or no)
MS Geo. Survey
 (organization running log)
 (8) how well bottom plugged BW Valve

description of formations encountered	from	to
Surface Casing	0	18
Blue Clay	18	30
Gumbo	30	270
Sand	270	300
Gumbo	300	660
Streaked Sand & Gumbo	660	690
Pink & Gray Gumbo	690	720
Gumbo	720	930
Streaked Gumbo & Sand	930	960
Gumbo	960	1110
Streaked Sand & Gumbo	1110	1230
Sand	1230	1310
Streaked Sand & Gumbo	1310	1383

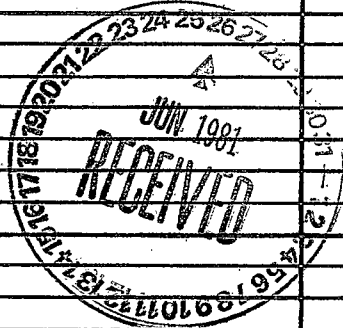

DRILLERS REMARKS:

7

If well telescopes please sketch and show depths.

GROUND LEVEL

1220' of 12" casing

Top of Log
1140'

Top of Screen
1222'


50' of 8" screen

10' of 8" blank

30' of 8" screen

B.W. Valve
1312'

If more than one screen, show locations of each on sketch.

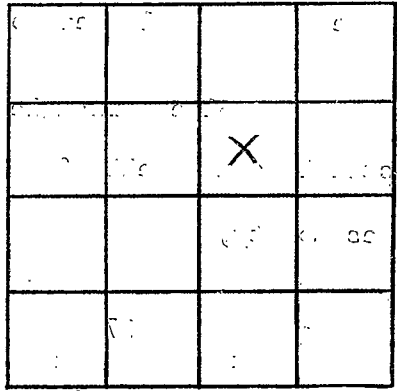

SECTION 6

Please indicate well location X.

ADDITIONAL INFORMATION

1220
50
1270
1312

1312