

LOWNDES  
K38  
5-22-81

MISSISSIPPI  
BOARD OF WATER COMMISSIONERS  
416 North State Street  
Jackson, Mississippi 39201

CODED

WATER WELL DRILLERS LOG

5/22 1981 ALL SUP Drilling LOWNDES  
date well completed firm name I.N.E.H. county well located

LANDOWNER: JOHN R. RICE  
P.O. Box 706  
Columbus, Miss. 39701  
(mailing address)

description of formations encountered	from	to
TOP SOIL	0	15
CHALK	15	48
WHITE ROCK	48	90
BLUE ROCK	90	185
HARD ROCK	185	350
MUCK	350	372
FINE SAND	372	380
MUCK	380	392
WATERSAND	392	472

WELL LOCATION:  
sec. 14 T. 18 N R. 17 E  
4 1/2 miles SW of Columbus  
(distance) (direction) (nearest town)

WELL PURPOSE: HOME  
(home, irrigation, municipal, industrial)

- WELL COMPLETION DATA:
- (1) diameter (inches) 4 X 2
  - (2) total depth (feet) 472
  - (3) static water level (feet) 701 below above top of ground.
  - (4) casing PVC 472  
(material) (depth)
  - 4 X 2 if telescope see back.  
(size)
  - (5) screen 80 392  
(length) (depth to top)  
2" No 10 PVC  
(size) (material)
  - (6) pump 1 1/2 3.5  
(HP) (yield gpm)  
Electric  
(type power)
  - (7) electric log no  
(yes or no)

(organization running log) Bearby  
(8) how well bottom plugged Agass  
valve

DRILLERS REMARKS:

CODED

DEPT. OF NATURAL RESOURCES  
BUREAU OF LAND & WATER RESOURCES

JUN 23 1981

RECEIVED

If well telescopes please  
sketch and show depths.

GROUND LEVEL


237'

2" casing

50' - 2" x 10'

Screen

160'

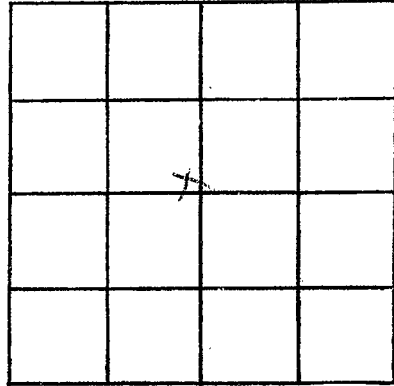

SECTION 14

Please indicate well location X.

ADDITIONAL INFORMATION

If more than one screen,  
show locations of each on sketch.