

MISSISSIPPI DEPARTMENT OF ENVIRONMENTAL QUALITY

Office of Land and Water Resources

P. O. Box 10631
Jackson, MS 39289-0631
WATER WELL DRILLERS LOG

COUNTY WELL LOCATED <u>Clarendon</u>	
WELL NUMBER <u>K-51</u>	CODED
DATE WELL COMPLETED <u>6/28/03</u>	

PERMIT NUMBER
NAME OF DRILLING FIRM <u>Clardy Drilling Columbus MS</u>

NAME & MAILING ADDRESS OF LANDOWNER <u>Synagro P.O. Box 9530 Columbus, MS 39705</u>			
Latitude: Longitude:			
WELL LOCATION	SEC	TOWNSHIP	RANGE
	<u>6</u>	<u>19 S</u>	<u>17 E</u>
DISTANCE	DIRECTION		NEAREST TOWN
<u>8</u> Miles	<u>S</u> of		<u>Columbus</u>
OTHER LANDMARK			
WELL PURPOSE: Home, Irrigation, Municipal, Industrial, Fish Pond, etc. <u>Office Grader</u>			

WELL DATA		
Well Depth <u>262</u>	Casing Diameter (In.) <u>4"</u>	Casing Length (Ft.) <u>145'</u>
Type of Casing <u>PVC</u>	Hole Depth <u>65</u>	Depth to Static Water Level
TYPE OF COMPLETION: (Circle One or More) Gravel Packed, Underreamed, <u>Telescoped</u> , Natural Development, Open Hole, Other		

WELL GROUTED TO A DEPTH OF 20 FEET
Type Grout (circle one): Cement, Bentonite, or Mix

SCREEN DATA		
Diameter - Inches <u>2"</u>	Length - Feet <u>40'</u>	Slot Size - Inches <u>.013</u>
Screen Type <u>PVC</u>	Depth to Bottom - Feet	

PUMP DATA		
PUMP TYPE (Circle One): <u>Submersible</u> , Turbine, Jet, Flowing Well, Other (Describe)		
POWER TYPE (Circle One): <u>Electric</u> , Tractor, Diesel, Gasoline, Butane, Other (Describe) <u>H/P 3/4</u>		
DESCRIPTION OF FORMATIONS ENCOUNTERED	FROM	TO
<u>Brown clay</u>	<u>0</u>	<u>10</u>
<u>White clay</u>	<u>10</u>	<u>15</u>
<u>Blue clay</u>	<u>15</u>	<u>72</u>
<u>Sandy clay</u>	<u>72</u>	<u>82</u>
<u>Rocky</u>	<u>82</u>	<u>87</u>
<u>Sandy clay</u>	<u>87</u>	<u>162</u>
<u>fine sandy clay</u>	<u>162</u>	<u>179</u>
<u>sandy clay</u>	<u>179</u>	<u>182</u>
<u>sand streak</u>	<u>182</u>	<u>192</u>
<u>fine sandy clay</u>	<u>192</u>	<u>224</u>
<u>fine sand</u>	<u>224</u>	<u>238</u>
<u>sandy clay</u>	<u>238</u>	<u>256</u>
<u>sand streak</u>	<u>256</u>	<u>257</u>
<u>sandy clay</u>	<u>257</u>	<u>262</u>

RECEIVED

AUG 01 2003

BY: OLWR

Top of Lap Pipe or Reduction in Casing

FEET IF TELESCOPED OR MORE THAN ONE SCREEN: USE BACK PAGE

I certify that the well was drilled, constructed and completed in accordance with all applicable Requirements of the Mississippi Department of Environmental Quality and/or the Mississippi Department of Health regulations and state laws.


Donald B. King 0-496
Signature of Licensed Driller and License No.

7/28/03
Date

Additional Information Required On Back

If well telescopes please sketch and show depths.

GROUND LEVEL

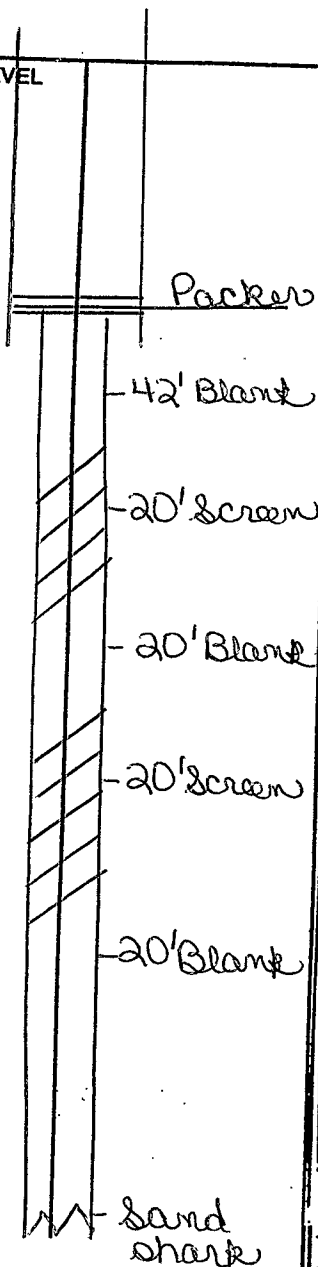

SECTION _____

Please indicate well location X.

Pump Capacity (GPM)	No. of Stages	Setting Depth
15	12	140 FT.

PUMP TEST

Well yielded _____ GPM with a drawdown of _____ ft. after _____ hours of pumping

LOG DATA

TYPE OF LOG RUN (Circle One): No Log Run, Electric, Gamma Ray, Density, Sonic, Neutron, Other (Describe) _____

Name of Organization Running Log _____

GEOLOGIC DATA (Office Use Only)

Surface Elev.	Geologic Unit	Unit Thickness	Depth to Top
Subs. SWL	Date	Analysis	Aquifer Test

Driller's Remarks

If more than one screen, show location of each on sketch.