	State Well Report			
County: Low Mbes	Part 1 – Driller's Log	For Office Use Only:		
Missis	sippi Department of Environmental Quality	Aquifer:		
Permit #:	Office of Land and Water Resources			
Driller: Parks of Maks	P.O. Box 10631	Well #: X - 55		
1	Jackson, MS 39289-0631	L. S. Elevation:		
Date drilling completed: 10/16/07	(601)961-5210			
	(601)354-6938 (fax)	E-log #:		
Department at the above address within	epared by the license holder responsible for a 30 days of completion of drilling of the well	or borehole.		
Information on Well Owner (Landowner if borehole is not for a water well)		orehole Location		
	I atitude:	" Longitude: " "		
Owner Name FRANK TIMES	Latitude.	Longitude		
Mailing Address: 1/15 Neikson	Method of Lat/Long (circle or	ne): Conventional Survey,		
	I IISGS and Hand-held	GPS, Survey-grade GPS		
Slean, MS 39	7766	, , ,		
	¼¼ Sec_32	Twn 18N Rng R17E		
City State	Zip Code Distance Direction	Nearest Town		
		of Columbus		
Telephone No. (662) 386-627	00			
	Well / Borehole Data			
Date drilling started:	r drilling:	Hole diameter:		
Logs run (circle all applicable). No log run Electroname of organization running log(s):	_	Other:		
Purpose of borehole (check one): Water Well	eotechnical/Geological Investigation Ground	Source Heat Pump		
Seismic Survey	Other (describe) well construction, skip the remainder of this blo	ck		
Purpose of Well (check one): Home Industrial	Public SupplyIrrigationFish Culture_	Other:		
If a flowing well, method of flow regulation: Valve	Other (describe)			
Static Water Level:59feet above or be	low (circle one) land surface Date measured:_	10/16/07		
Method of Measurement (circle one) steel tape	electric tape air line other:			
Well depth: 715 Well grouted to a depth of 5				
Casing length:feet	er: 412 inches Type of casing:	See!		
Screen length: 40 feet Screen diamet	_	Stainless STEO		
Screen slot size: 600 inches Setting depth: From 685 feet to 725 feet				

Type of completion (circle all applicable) Gravel packed Underreamed Telescoped

Top of lap pipe or reduction in casing:

Other (describe):

NOVINO QLE 200 EWR-1A

BY: OLWE


Natural Development

Open hole

feet. If telescoped or more than one screen, de Record Editor

wells and boreholes, unless specifically exempted by regulations

If well telescopes, show depths on sketch.	wells and boreholes, unless specifically exempted by regulations		
Ground Level	Description of Formations Encountered	From (depth)	To (depth)
SU FEBT COMONT &		Ground Level	To (depai)
	45	0	180
MANANA CITA CITA CITA CITA CITA CITA CITA CIT	C/RG.	180	444
570 FOET 4'CHING B	CAY SAND	444	584
210 100 4 CADING	CIAG	584	665
	SANO	663	725
			ļ <u>.</u>
		·	
		ļ	
		+	
			
111111111111111111111111111111111111111		<u> </u>	
4 x2 Swalac 570-4"		 	ļ
105'-2"Swedge 570'-4"			
162 - 9 814C			
GRAVE PACK			
27.7			
46-55 SCDOON 25 5		 	
-40-33 3CD000			
111/47		J	
If more than one screen, show location of each on sketch			

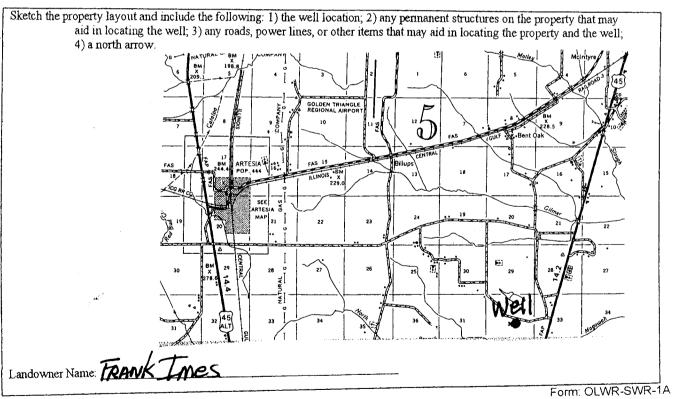

I certify that the well/borehole was drilled, constructed, and completed in accordance with all applicable requirements of the Mississippi Department of Environmental Quality and the Mississippi Department of Health re-Date Print Name of Responsible Licensee and License No.

STATE WELL REPORT

Permit #: Driller: Tanks Panks Part 2 Pump Installer's Comp Mississippi Department of En Office of Land and Wa P.O. Box 106

Date completed:

Pump Installer's Completion Report
Mississippi Department of Environmental Quality
Office of Land and Water Resources
P.O. Box 10631
Jackson, MS 39289-0631
(601)961-5210
(601)354-6938 (fax)

For Office Use Only:		
Aquifer:		
Well #:	K-55	
Elevation	n:	

Copy information from block on Part 1 (601)354-6938 (fax)
This part of the report must be completed by a licensed water we report must be attached and both parts filed with the Departmen	ell contractor or a licensed pump installer. A copy of Part 1 of the nt at the above address within 30 days of well completion.
Well Owner Information	Well Location
Owner Name: FRANK IMES	Latitude:Longitude:
Mailing Address: 1115 Neilson ROAD	Method of Lat/Long (check one): Conventional Survey,
SIEEN, MS 35766	USGS quad, Hand-held GPS, Survey-grade GPS
City State Zip Code	¼¼ Sec32T18N R RIJE
ony Blate Bip Code	Distance Direction Nearest Town
Telephone No. (66) 386 - 6270	9 Miles South of Columbus
Pump Type Circle one	Power Type Circle one
Air Lift Jet Submersible	Diesel Engine Gasoline Engine Natural Gas
Bucket Piston Turbine	Electric Motor Hand Tractor PTO
Centrifugal Rotary Flowing Well	Windmill Other (specify):
Other (specify):	Horse Power Rating of Motor:
Date Pump Installed: /0/16/07	Setting Depth:feet
Rated Pump Capacity: Gallons Per Minute	Number of Stages:
Pump Test Data	Method of Measuring Water Level
Date Well Tested: 10/16/07	Circle one Air Line Electric Measuring Line Steel Tape
Static Water Level (A):Feet Below Land Surface	
Pumping Water Level (B):Feet Below Land Surface	Other (specify):
Drawdown [(B) – (A)]:Feet Below Land Surface	For flowing well, measured shut in head:feet
Test Pumping Rate:Gallons Per Minute	Well yieldedGPM with a drawdown of
Duration of Pump Test (minimum 4 hours):hours	feet afterhours of pumping
I HEREBY CERTIFY that the above statements are true to the best	of my knowledge:
Print Name of Pump Installer and License No. (if applicable)	Signature if Pump Installer

BYOLWA