

Lowndes
B
K 2000
8-24-79

MISSISSIPPI
 BOARD OF WATER COMMISSIONERS
 416 North State Street
 Jackson, Mississippi 39201

WATER WELL DRILLERS LOG

Aug. 24
 date well completed

1979 ALLSOP Drilling Inc
 firm name

Lowndes
 county well located

LANDOWNER: Leon Kester
RR 1, Box 358
Columbus Ms. 39701
 (mailing address)

description of formations encountered	from	to
<u>Top Soil</u>	<u>0</u>	<u>2</u>
<u>lime Rock</u>	<u>2</u>	<u>352</u>
<u>1st SAND</u>	<u>352</u>	<u>402</u>
<u>Muck</u>	<u>402</u>	<u>452</u>
<u>2nd SAND</u>	<u>452</u>	<u>550</u>

WELL LOCATION:
 sec. 19 T 18 N R. 17 E
6 1/2 miles E of Artesia
 (distance) (direction) (nearest town)

WELL PURPOSE: home
 (home, irrigation, municipal, industrial)

WELL COMPLETION DATA:
 (1) diameter (inches) 4" X 2"
 (2) total depth (feet) 550'
 (3) static water level (feet) 40 below top of ground
 (4) casing plastic, 26' (material) (depth)
4" X 2" If telescope see back. (size)
 (5) screen 20' 470' (length) (depth to top)
4" X 2" plastic (size) (material)
 (6) pump 1/2 10 (HP) (yield gpm)
Electric (type power)
 (7) electric log NO (yes or no)

(8) how well bottom plugged CAP
 (organization running log)


DRILLERS REMARKS:

DEPT. OF NATURAL RESOURCES
 BUREAU OF LAND & WATER RESOURCES
 OCT 16 1979
 RECEIVED

If well telescopes please sketch and show depths.

GROUND LEVEL

26'
4" casing

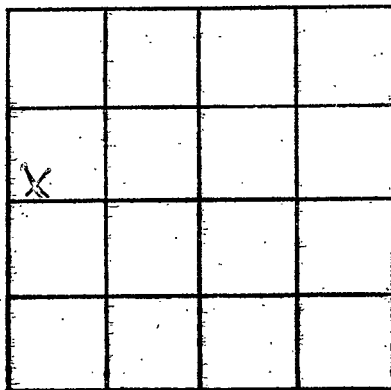

SECTION 19

Please indicate well location X.

ADDITIONAL INFORMATION

186'2"
Casing
80'2"
Connexed
Screen

If more than one screen,
show locations of each on sketch.