

MISSISSIPPI DEPARTMENT OF NATURAL RESOURCES
Bureau of Land and Water Resources
 Southport Mall
 P.O. Box 10631
 Jackson, Mississippi 39209
WATER WELL DRILLERS LOG

Louder
R.
2002

8-13 1982 Clardy Hill Drilling Louder
 date well completed firm name county well located

LANDOWNER: Mack Howard
Old maeon Rd.
Columbus, Ms.
 (mailing address)

WELL LOCATION:
 sec. 11 T. 18 N. R. 19 E.
5 miles SW of Col.
 (distance) (direction) (nearest town)

WELL PURPOSE: home
 (home, irrigation, municipal, industrial)

WELL COMPLETION DATA:


- (1) diameter (inches) 4"
- (2) total depth (feet) 562
- (3) static water level (feet) 60' below above top of ground.
- (4) casing PVC, 217'
 (material) (depth)
2 if telescope see back.
 (size)
- (5) screen 60'
 (length) (depth to top)
2" PVC
 (size) (material)
- (6) pump 5
 (HP) (yield gpm)
etc.
 (type power)
- (7) electric log no.
 (yes or no)
 DEPT. OF NATURAL RESOURCES
 BUREAU OF LAND & WATER RESOURCES
 (Organization furnishing log)
- (8) how well bottom placed
OK 1-1982

description of formations encountered	from	to
Limes rock	9-	14
blue clay	14	66
sandy clay	66	72
rock	72	73
sandy clay	73	208
blue clay (thin)	208	214
gummy clay	214	219
sandy clay	219	233
carb. clay	233	241
sandy clay	241	262
sand & coal	262	260
clay	260	276
good sand	276	282
fine sand	282	296
band	296	302
sandy clay	302	318
hard clay	318	339
fine sand	339	352
clay	352	356
good sand	356	362
gummy brown clay	362	384
sandy clay	384	385 1/2
rock	385 1/2	386
sandy clay	386	405 1/2
brown clay	405 1/2	426
sandy clay	426	434
brown clay	434	462
sand (fine)	462	464
sand	464	474
clay	474	484
good sand	484	495
clay	495	499
sandy clay	499	562
good sand	562	562

RECEIVED

If well telescopes please sketch and show depths.

GROUND LEVEL

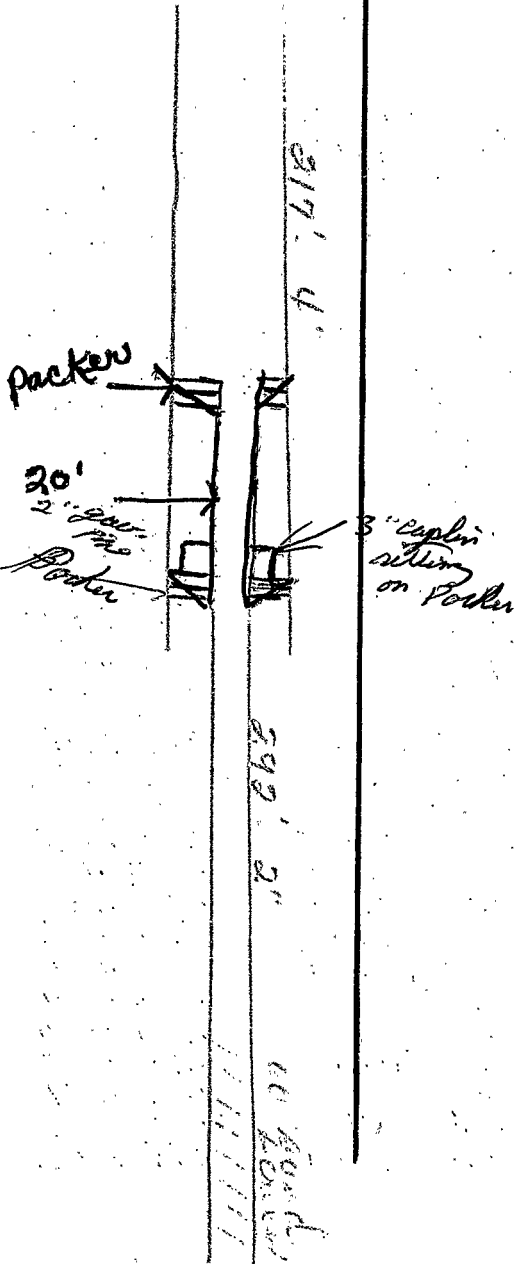

SECTION _____

Please indicate well location X.

ADDITIONAL INFORMATION

If more than one screen, show locations of each on sketch.